
SECTION 10, TWP.4 S. RANGE 13 E. W.M. WASCO COUNTY, OREGON

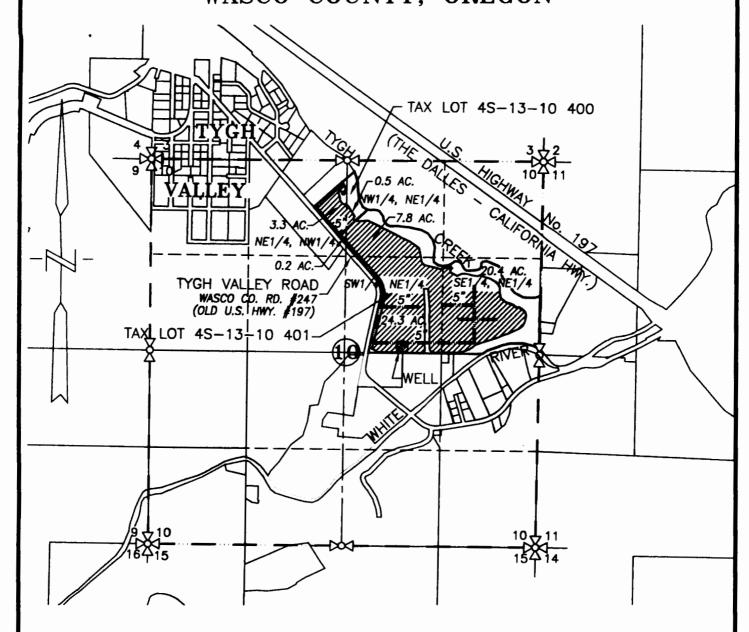

WELL: 2,705' N. & 3,450' E. OF SW COR. SEC. 10 RECEIVED



IRRIGATED AREA = 56.5 ACRES

5" IRRIGATION MAIN

WATER RESOURCES DEPT SALEM, OREGON

CLAIM OF BENEFICIAL USE MAP

SCALE: 1"= 1320' 660′ 1320′ 2640'

TRANSFER	No.	6789


IN THE NAME OF:

JONNIE AND FRED JUSTESEN

DATE: NOVEMBER 21, 2011

BY: TENNESON ENGINEERING CORP.

3313 W. 2ND. STREET, SUITE 100 THE DALLES, OREGON. 97058 PH. 541-296-9177 FAX 541-296-6657

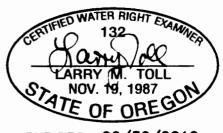

EXPIRES: 06/30/2012

NOTE:

"THIS MAP IS NOT INTENDED TO PROVIDE DIMENSIONS OR LOCATIONS OF PROPERTY OWNERSHIP LINES."

W.O. #8509A