


MAP TO ACCOMPANY APPLICATION TO CHANGE PLACE OF USE AND POINT OF APPROPRIATION FOR TOM AND SUSAN MOREHOUSE

FROM
TAX LOT 2501
IN SECTION 13, TOWNSHIP 27 SOUTH, RANGE 17 EAST, W.M.
LAKE COUNTY, OREGON

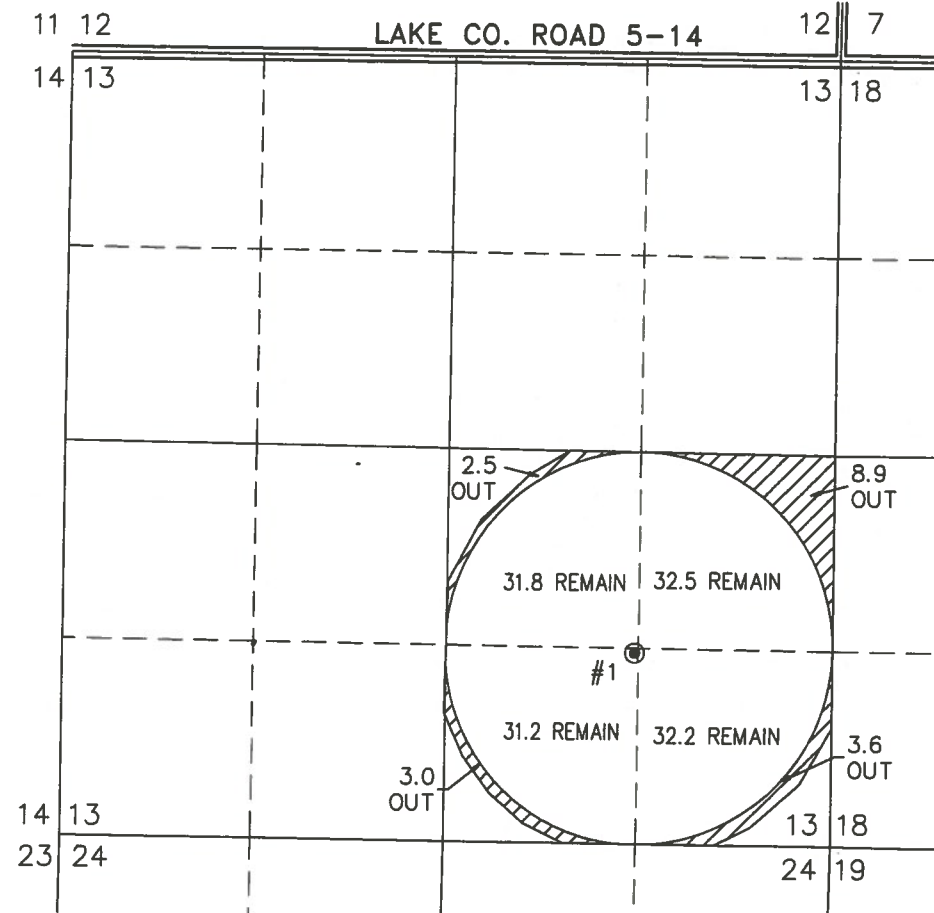

LAKE 992 G-8195

● #1 WELL LOCATED IN THE SW 1/4 SE 1/4 AND 1360 FEET SOUTH
AND 1350 FEET WEST FROM THE EAST 1/4 CORNER OF SECTION 13.

LAKE 1054 PROPOSED


● #2 WELL LOCATED IN THE NW 1/4 NE 1/4 AND 1300 FEET SOUTH
AND 2500 FEET WEST FROM THE NE CORNER OF SECTION 24.



18.0 ACRES WATER RIGHTS FROM C #54691
(G-8195) TRANSFERRED, AS SHOWN.



TO
TAX LOT 2502
IN SECTION 24
TOWNSHIP 27 SOUTH, RANGE 17 EAST, W.M.
LAKE COUNTY, OREGON

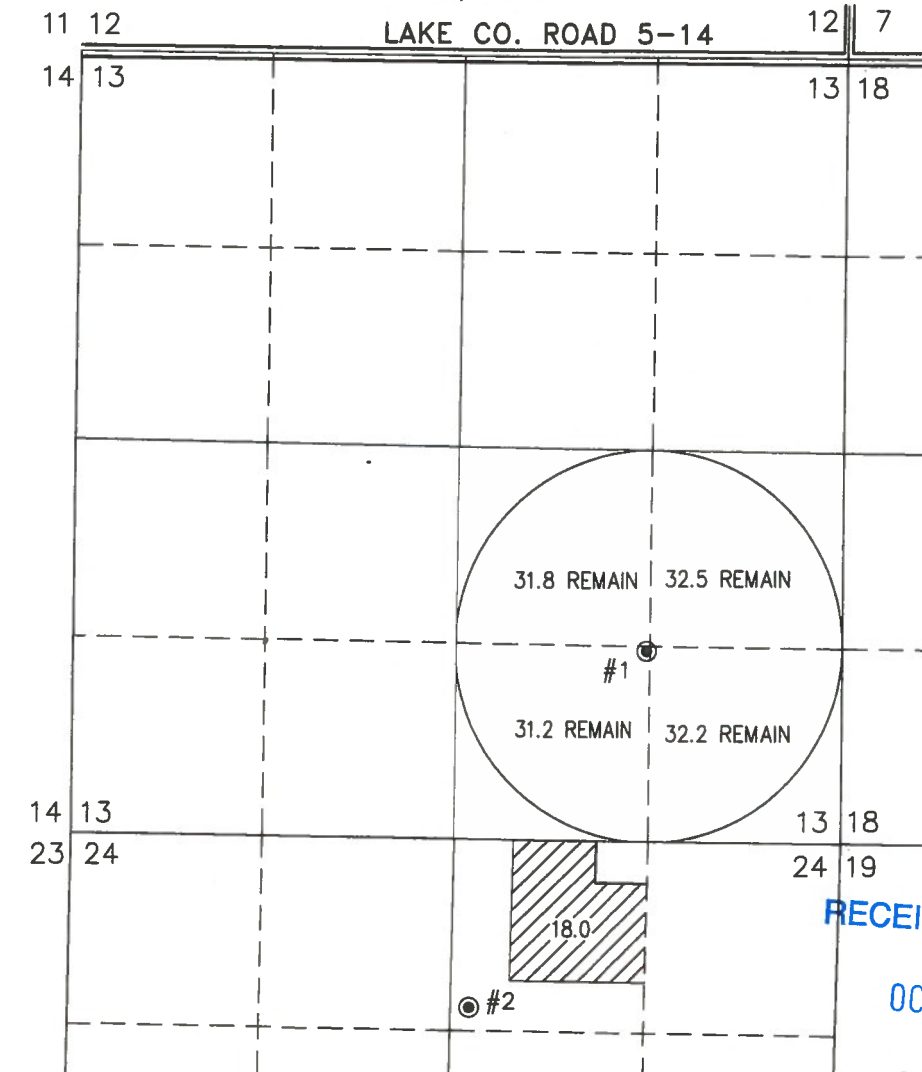

RECEIVED BY OWRD

OCT 07 2015

SALEM, OR

THIS MAP IS FOR THE PURPOSE OF LOCATING A WATER RIGHT ONLY AND HAS NO
INTENT TO PROVIDE LEGAL DIMENSIONS OR THE LOCATION OF PROPERTY LINES.

PROJECT No. 15-086

PREPARED AT THE REQUEST OF:

TOM & SUSAN MOREHOUSE
P.O. BOX 13
CHRISTMAS VALLEY, OR 97641

ALL POINTS ENGINEERING
& SURVEYING, INC.



P.O. BOX 767
TERREBONNE, OREGON 97760
(541) 548-5833 PH
Scott@APEandS.com
www.APEandS.com



RENEWAL DATE: 12/31/2016

T 12177