


ACMPC Oregon 3, LLC Neck Rd. farm

Revised 4-20-16 ~~WEM~~

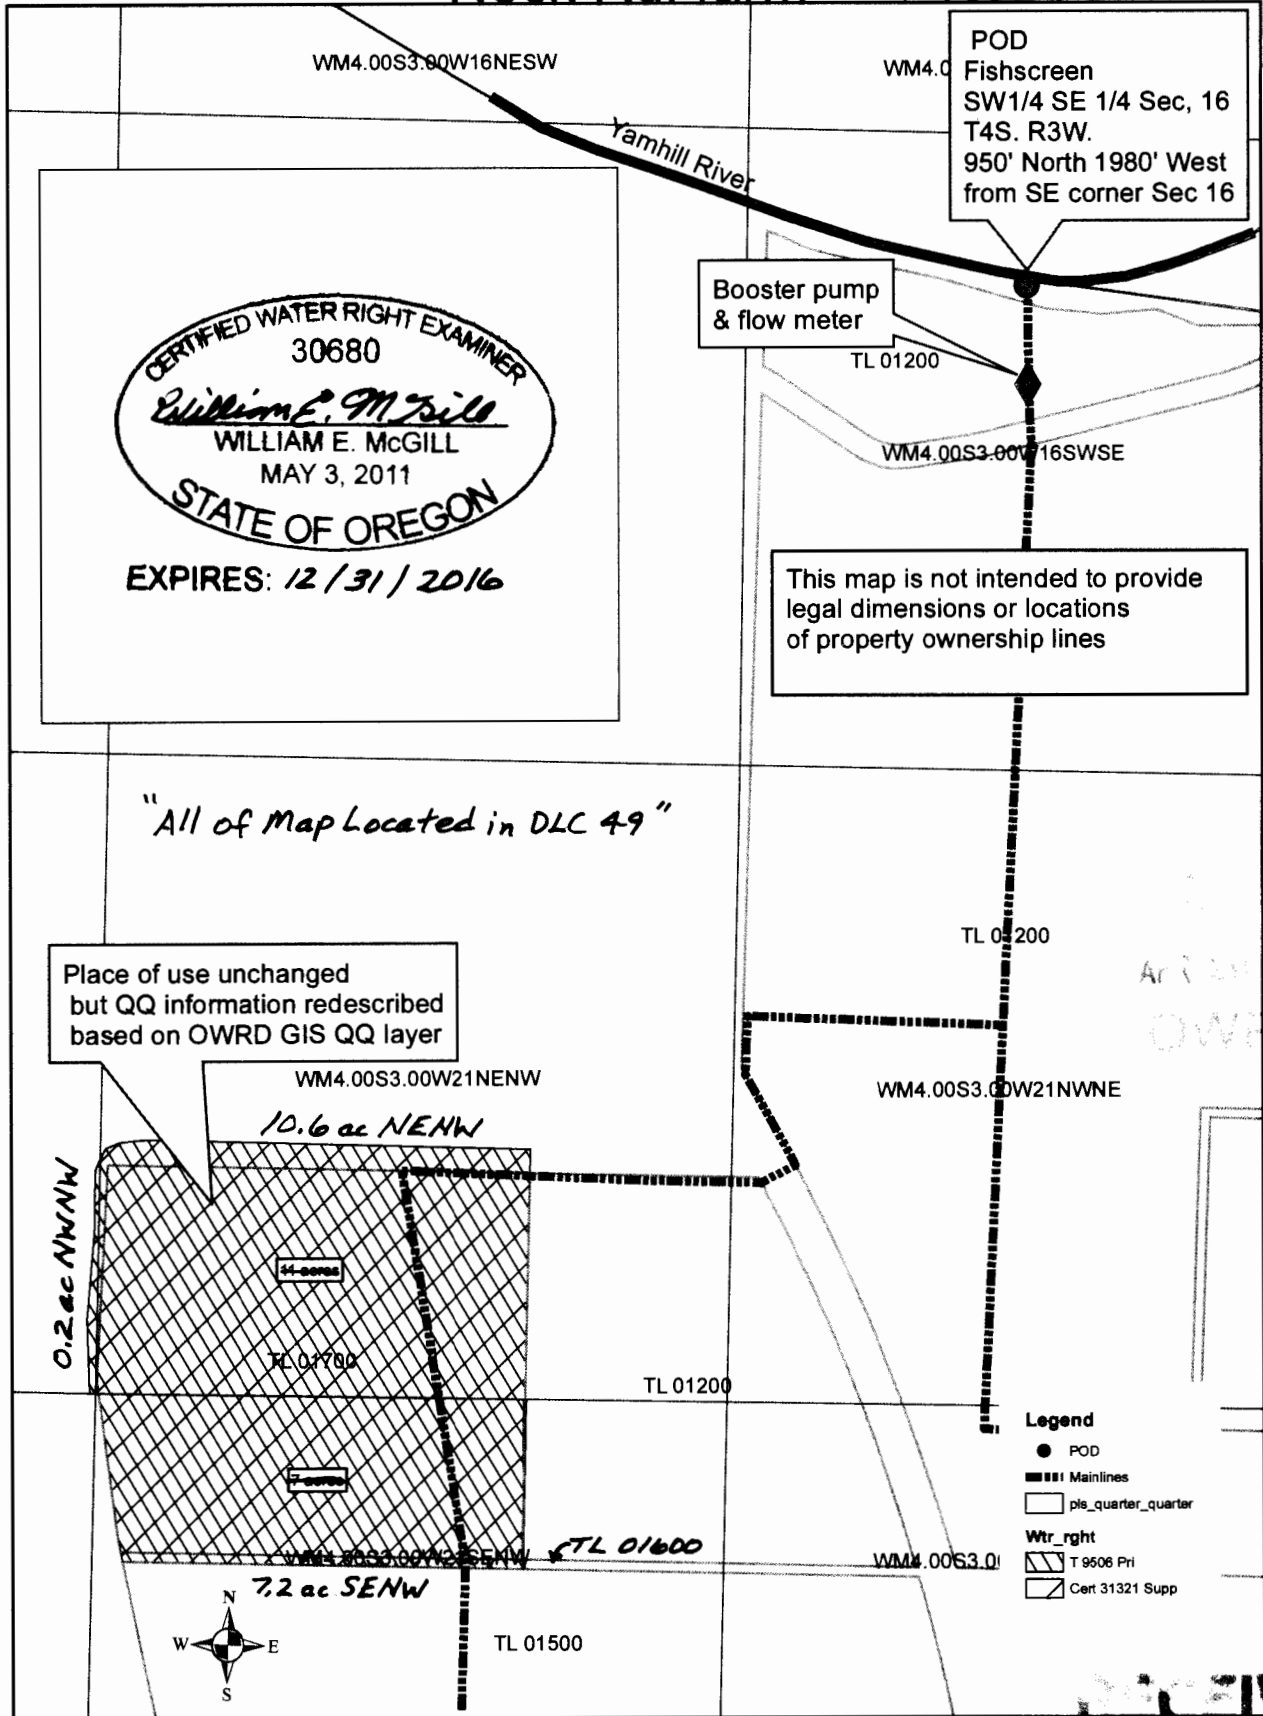

CERTIFIED WATER RIGHT EXAMINER
30680
William E. McGill
WILLIAM E. MCGILL
MAY 3, 2011
STATE OF OREGON
EXPIRES: 12/31/2016

Booster pump
& flow meter

POD
Fishscreen
SW 1/4 SE 1/4 Sec, 16
T4S. R3W.
950' North 1980' West
from SE corner Sec 16

This map is not intended to provide
legal dimensions or locations
of property ownership lines

Place of use unchanged
but QQ information redescribed
based on OWRD GIS QQ layer

"All of Map Located in DLC 49"

Ar 7 2015
OWRD

- Legend**
- POD
 - Mainlines
 - - - pie_quarter_quarter
 - Wtr_right
 - ▨ T 9506 Pri
 - ▩ Cert 31321 Supp

0 200 400 800 Feet

Application S 32148
Transfer 9506 COBU map
Prepared by Stevenson/McGill

MAR 11 2016

WATER RESOURCES DEPT

RECEIVED