


Department
Prepared
map.

This Map for Assessment
and Taxation Purposes
ONLY

SEC.35 T6S R6W WM
POLK COUNTY

Scale 1" = 400'

6.6.35

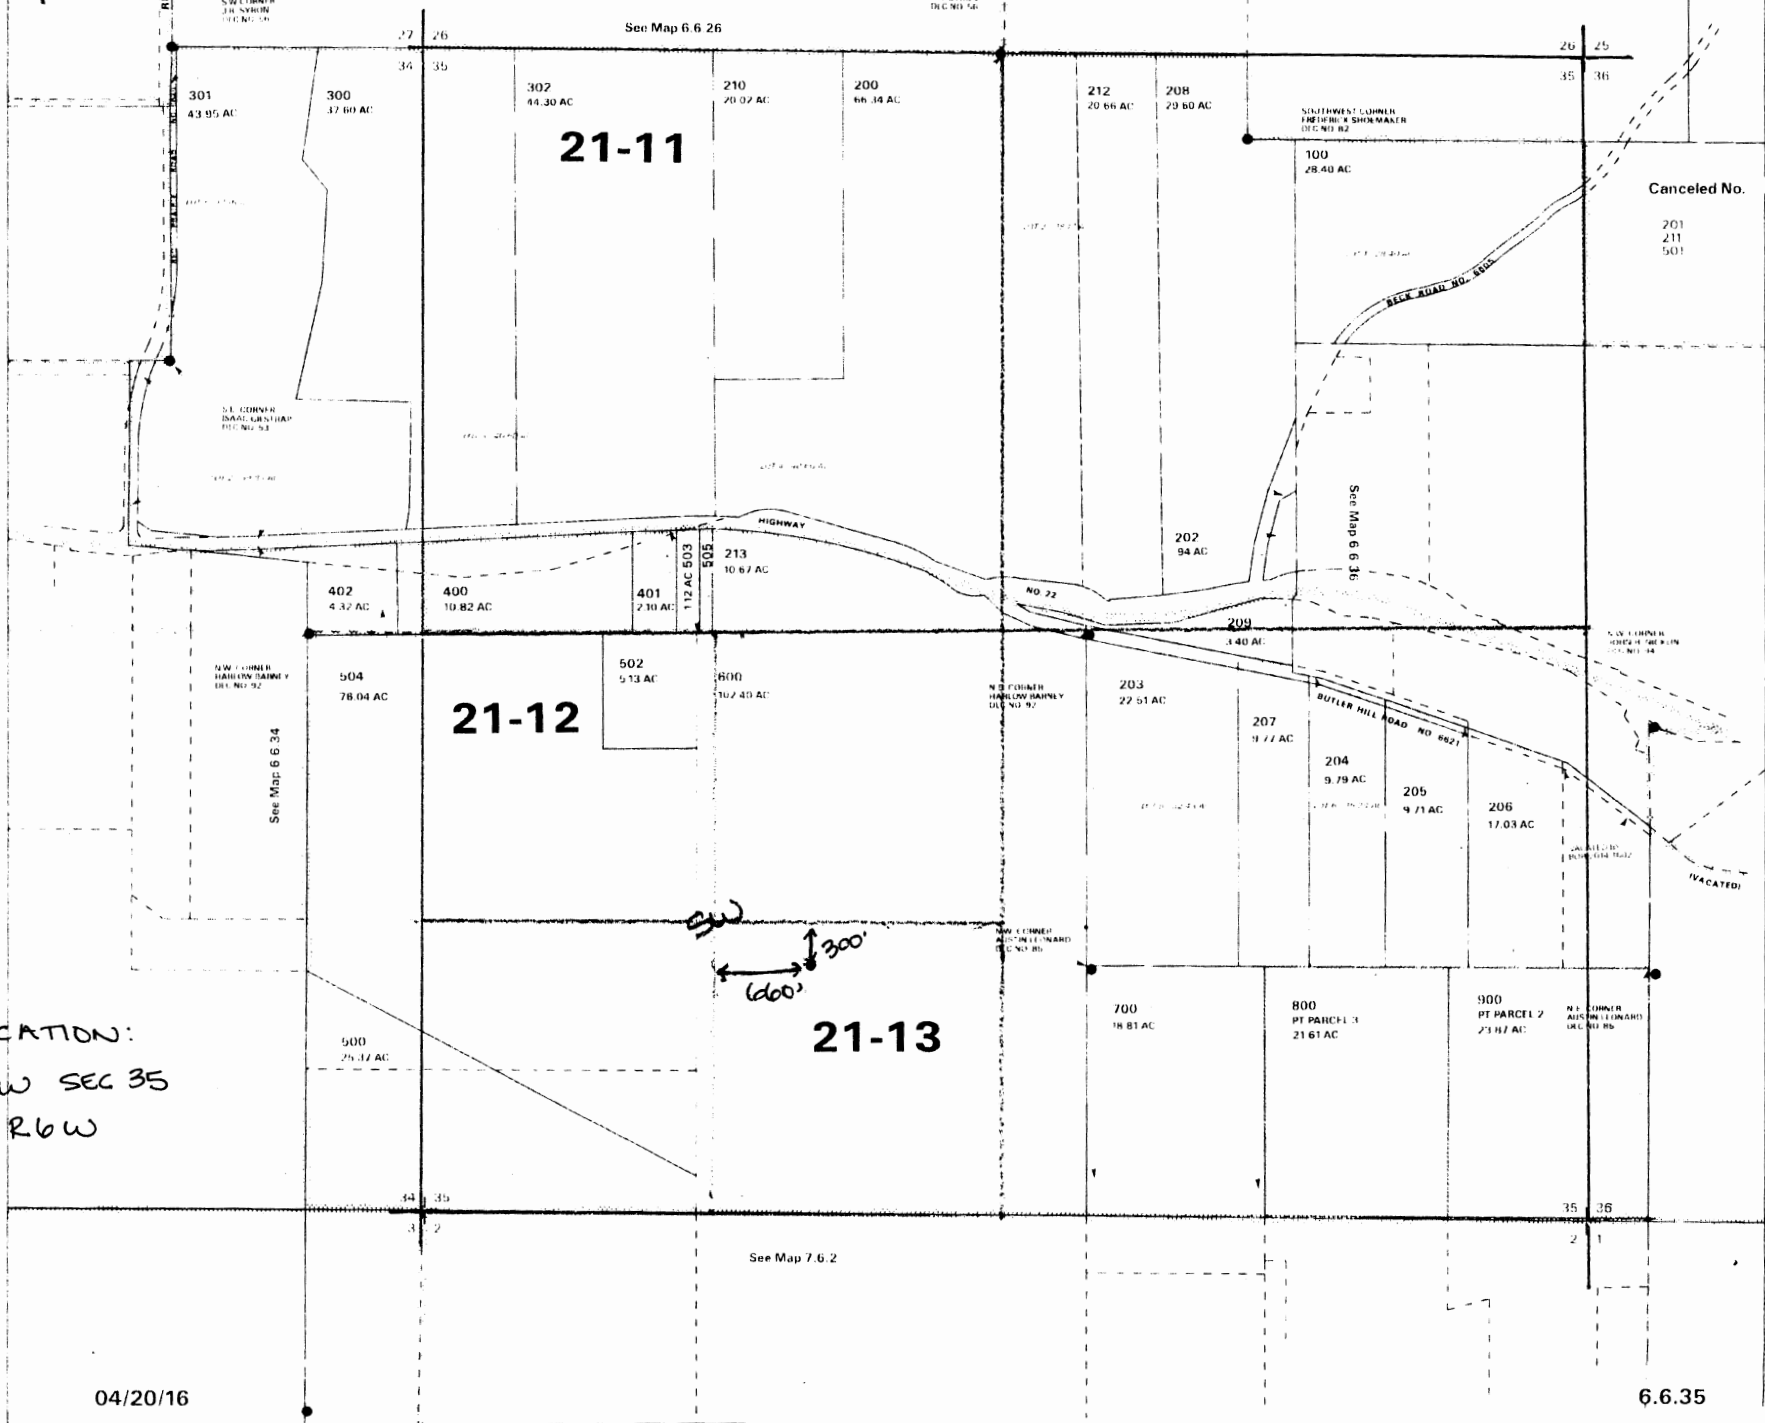

RES LOCATION:
SESW SEC 35
T6 S R6W

SW
300'
660'

04/20/16

6.6.35