694

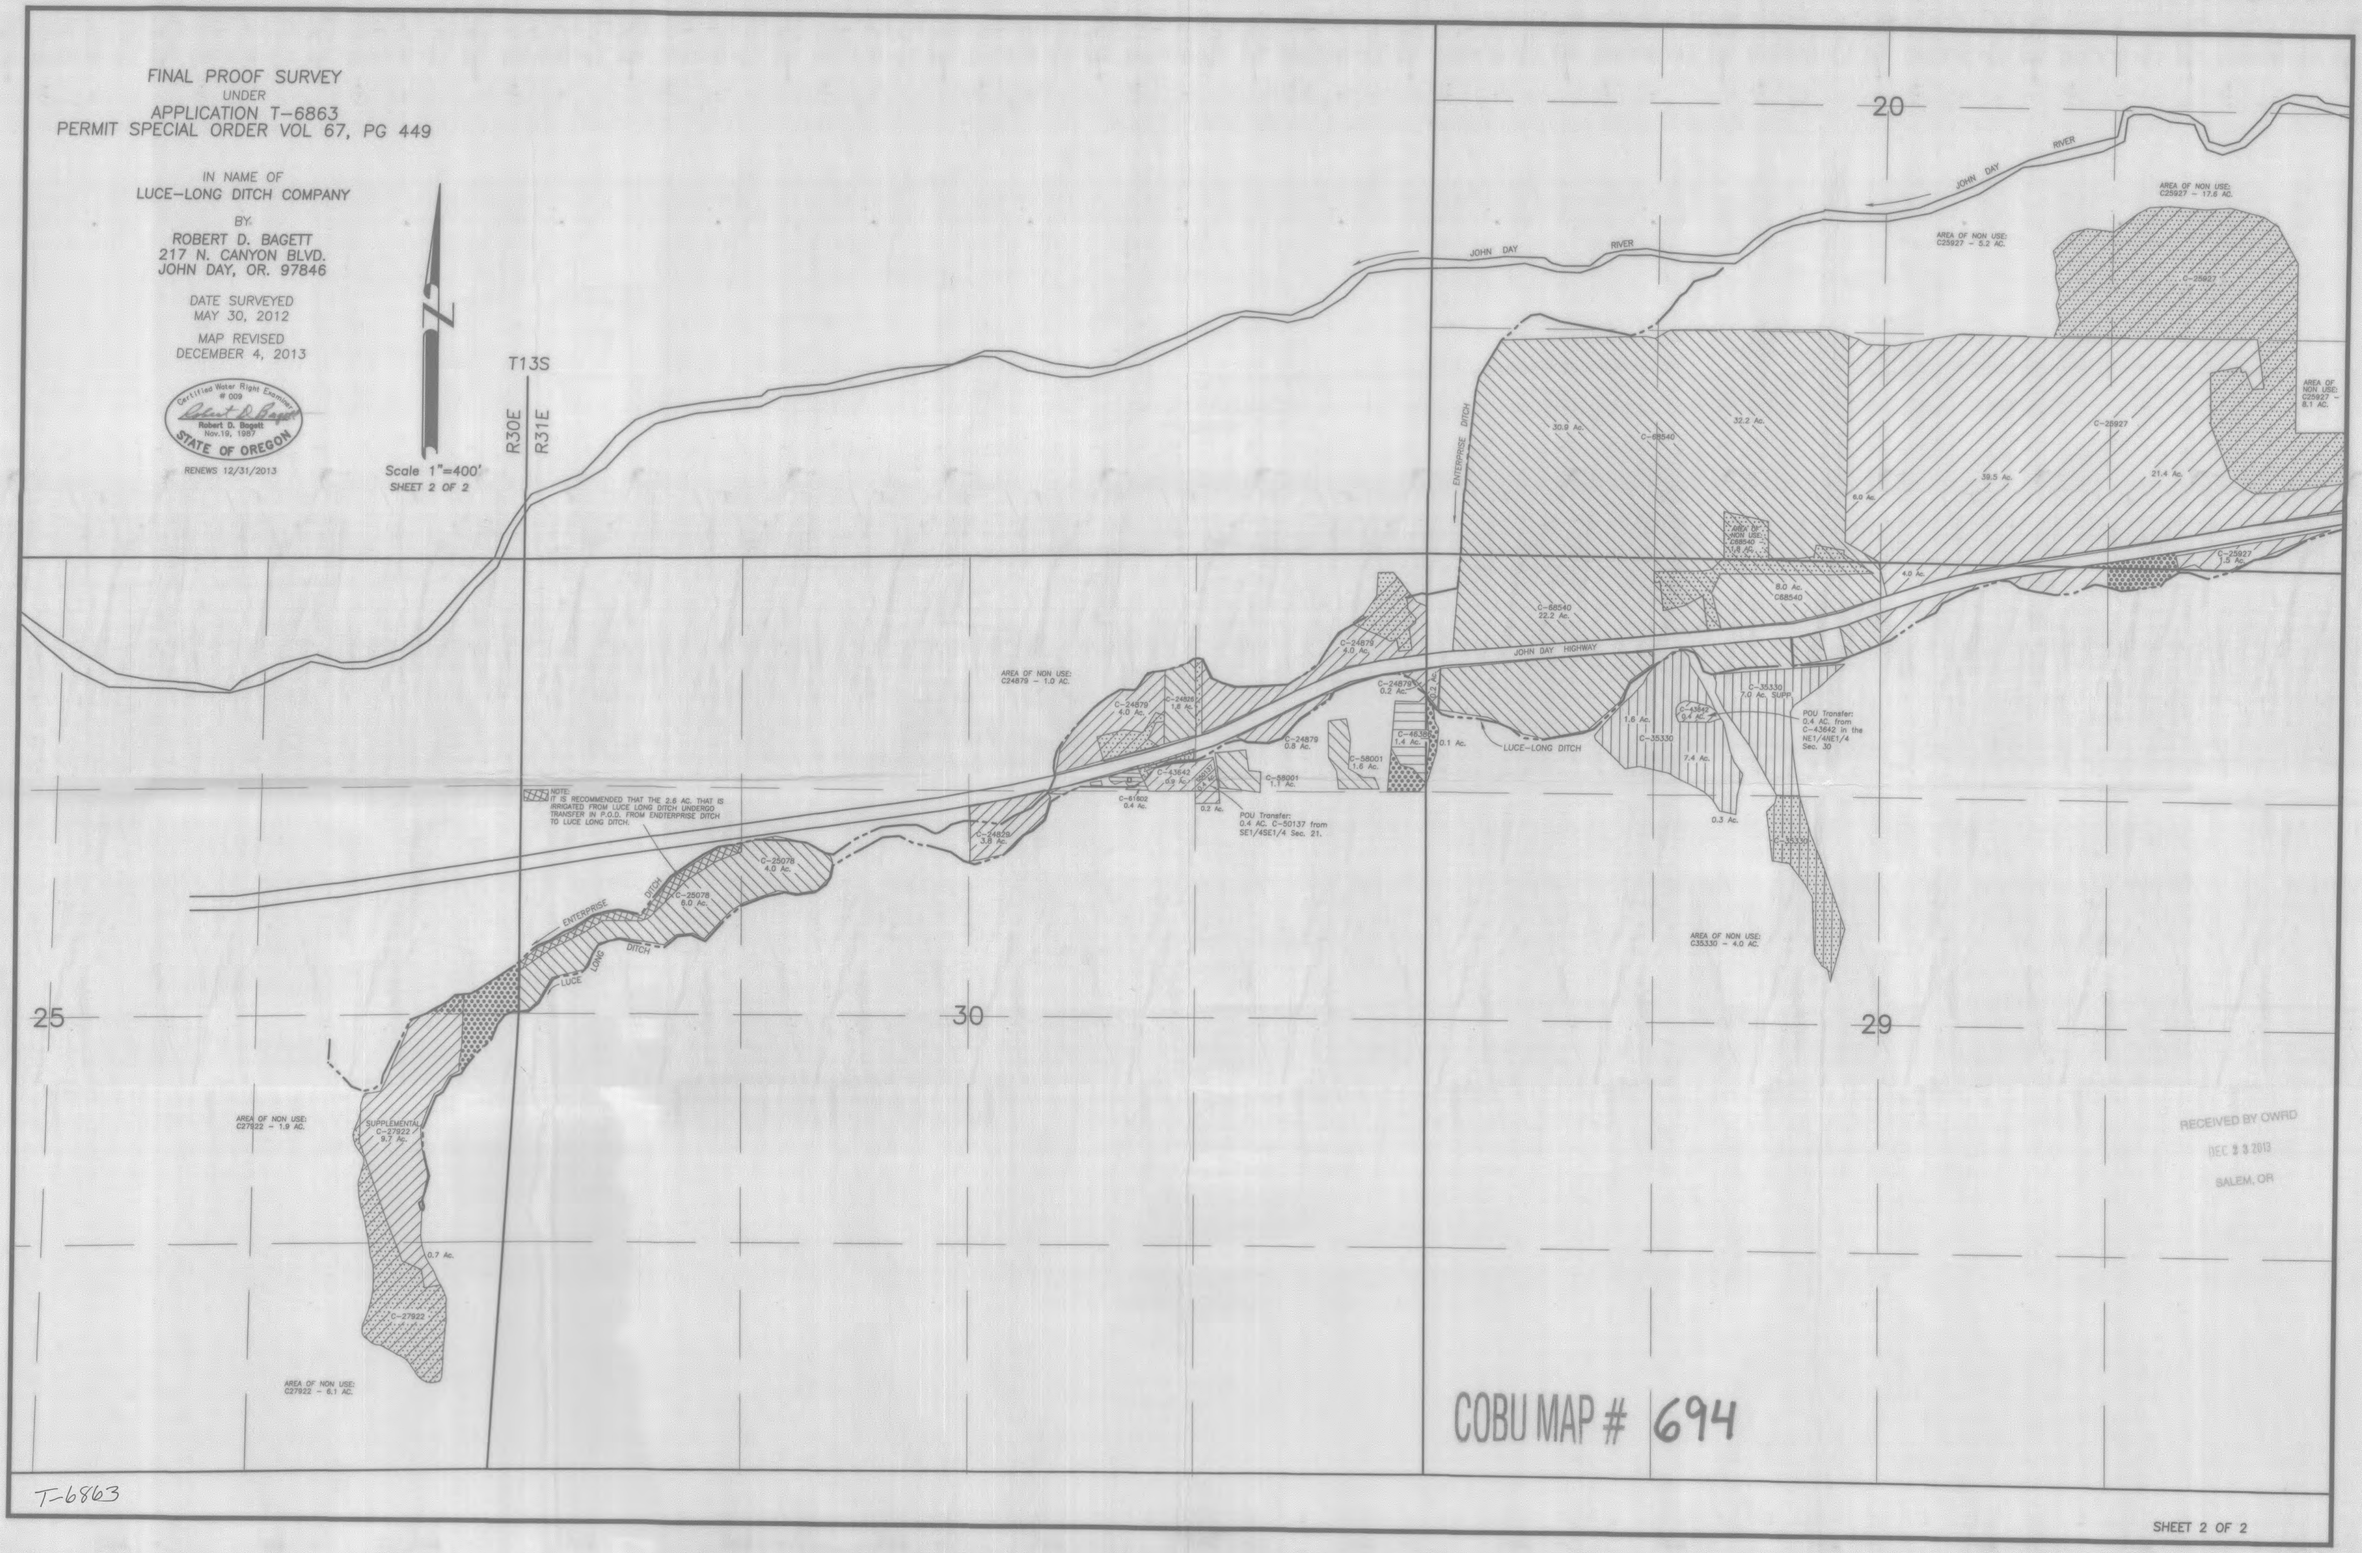
FINAL PROOF SURVEY
UNDER
APPLICATION T-6863
PERMIT SPECIAL ORDER VOL 67, PG 449
IN NAME OF
LUCE-LONG DITCH COMPANY
BY
ROBERT D. BAGETT
217 N. CANYON BLVD.
JOHN DAY, OR. 97846
DATE SURVEYED
MAY 30, 2012
MAP REVISED
DECEMBER 4, 2013
Certified Water Right Examiner
009
Robert D. Bagett
Nov.19, 1987
STATE OF OREGON
RENEWS 12/31/2013
Scale 1"=400'
SHEET 2 OF 2
T13S
R30E
R31E
20
25
30
29
JOHN DAY RIVER
JOHN DAY HIGHWAY
ENTERPRISE DITCH
LUCE-LONG DITCH
AREA OF NON USE: C25927 - 17.6 AC.
AREA OF NON USE: C25927 - 5.2 AC.
AREA OF NON USE: C25927 - 8.1 AC.
AREA OF NON USE: C24879 - 1.0 AC.
AREA OF NON USE: C35330 - 4.0 AC.
AREA OF NON USE: C27922 - 1.9 AC.
AREA OF NON USE: C27922 - 6.1 AC.
SUPPLEMENTAL C-27922 9.7 Ac.
C-27922
C-25927
C-68540
C-35330
C-24879
C-58001
C-25078
C-24829
C-43642
C-61602
C-24876
C-24826
C-46386
NOTE: IT IS RECOMMENDED THAT THE 2.6 AC. THAT IS IRRIGATED FROM LUCE LONG DITCH UNDERGO TRANSFER IN P.O.D. FROM ENDTERPRISE DITCH TO LUCE LONG DITCH.
POU Transfer: 0.4 AC. C-50137 from SE1/4SE1/4 Sec. 21.
POU Transfer: 0.4 AC. from C-43642 in the NE1/4NE1/4 Sec. 30
RECEIVED BY OWRD
DEC 23 2013
SALEM, OR
COBU MAP # 694
T-6863
SHEET 2 OF 2

694