


T.6 S., R.4 W., W.M.

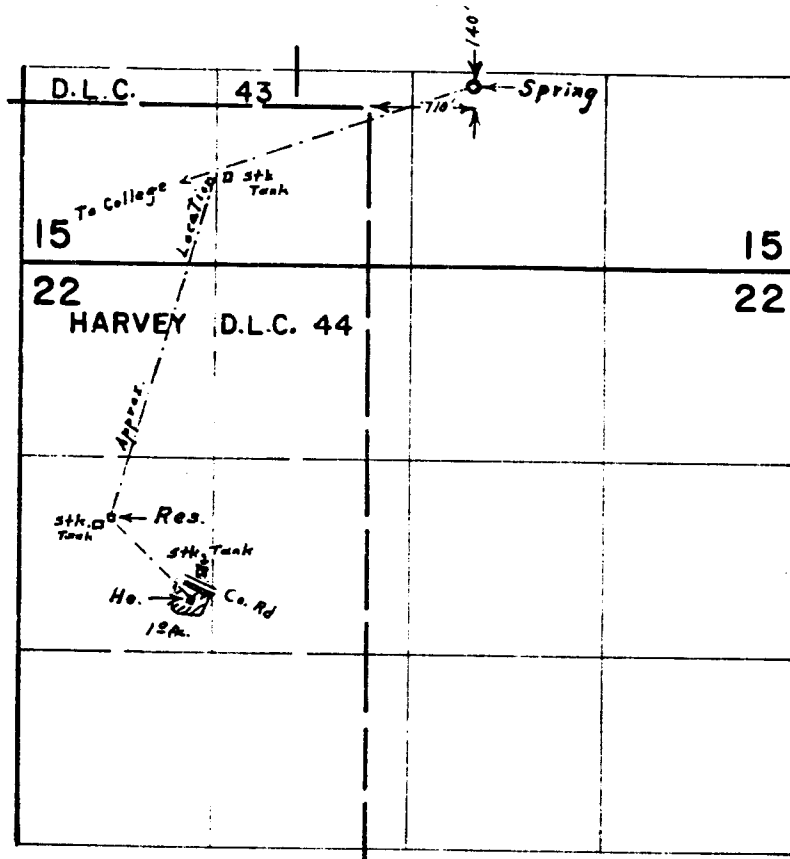

Transfer No. 3340

FINAL PROOF SURVEY
UNDER

Application No. 42784 Permit No. 31986
IN NAME OF
JULIUS MARX JR.

Surveyed April 27, 1972, by L. E. Gould