EXHIBIT "A"

CLAIM OF BENEFICAL USE MAP FOR PERMIT G-15277 AND T-10221 AND T-10222

Section 20, T.8S, R39E WM
Tax lot 200

N

- Map is not intended To provide legal dimensions or location of property ownership lines
- All hatchured area is being irrigated by center pivot hand lines or flood
- Acres were computed from Partition Plat P1993-003

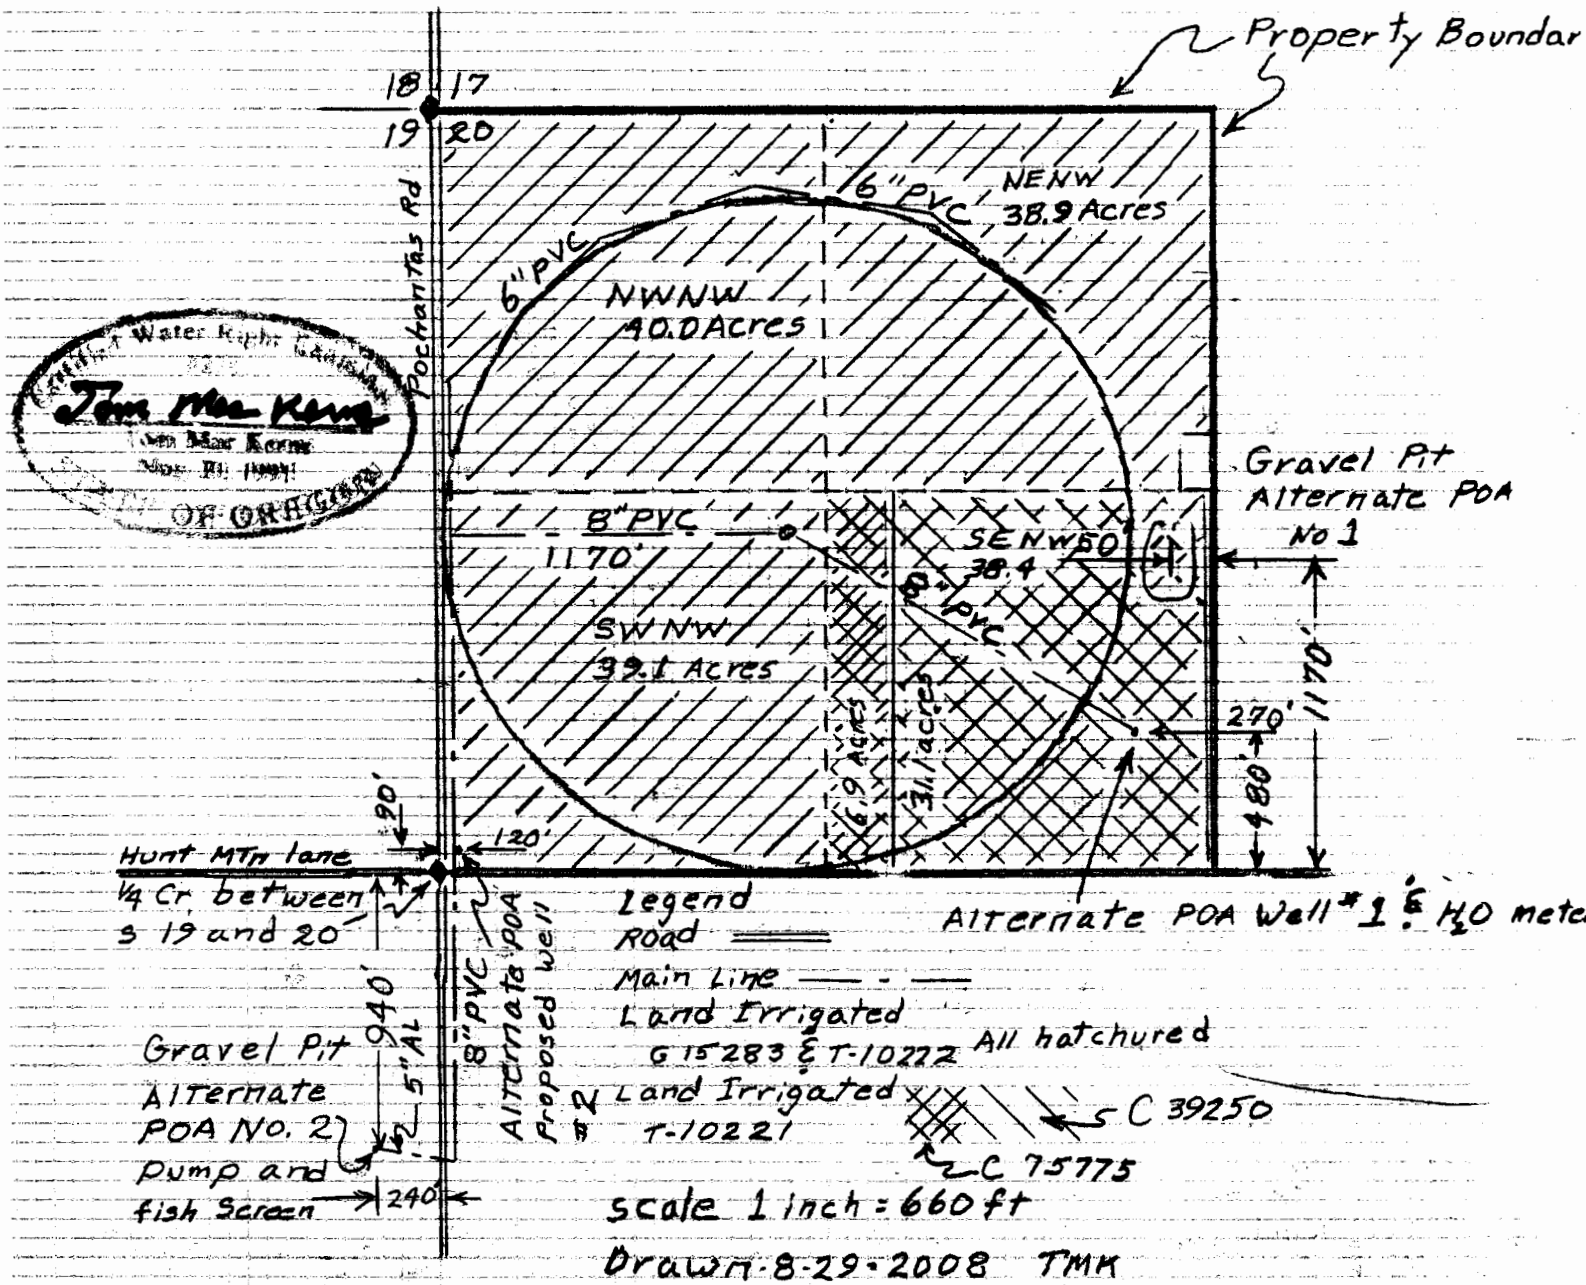

Water Right Examiner
Tom Mac Kerns
OREGON