


SECTION 8 T5N. R1W. WM.
COLUMBIA COUNTY
1" = 400'

5 1 8
8 INDEX
DEER ISLAND

RECEIVED
APR 12 2001
WATER RESOURCES DEPT
SALEM, OREGON

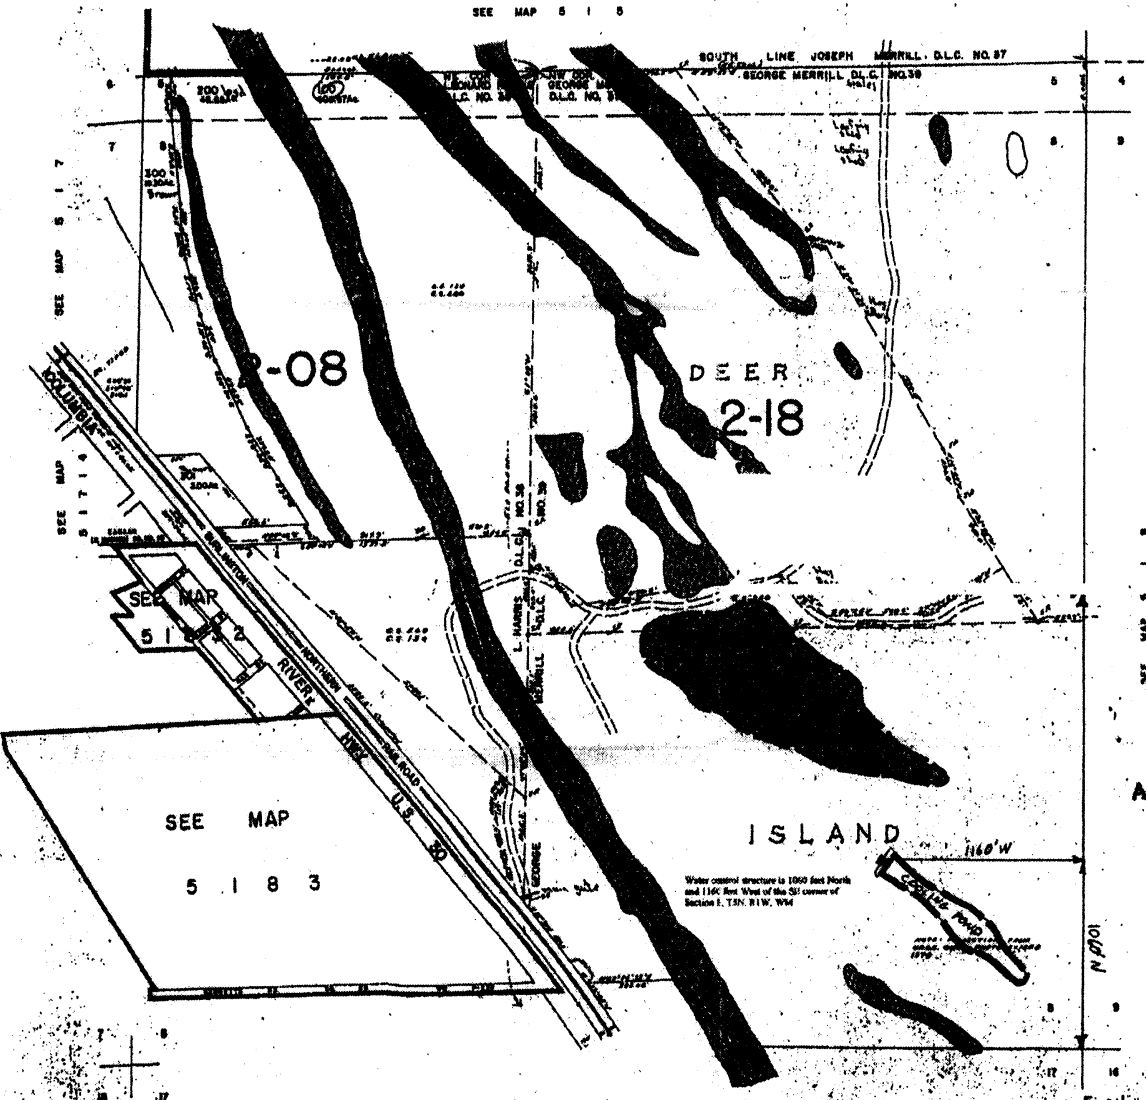

Application No. *R84745*
Permit No. *R-13154*

RECEIVED
MAY 2 2001
WATER RESOURCES DEPT
SALEM, OREGON

COOLING POND		
T5N. R1W		
Section 8	SW 1/4, SW 1/4	1/4 Sec 200

COOLING POND
Deer Island Stock Ranch
OR-0091-001
1/1

RECEIVED BY OWRD

FEB 16 2016

SALEM, OR