


FINAL PROOF MAP

TO ADD A POINT OF APPROPRIATION AND PLACE OF USE FOR APPLICATION G-17681 STEVE HELMS

TOWNSHIP 27 SOUTH, RANGE 34 EAST, SECTIONS 7 & 8, W.M.
TAX LOTS: 1200, & 1203

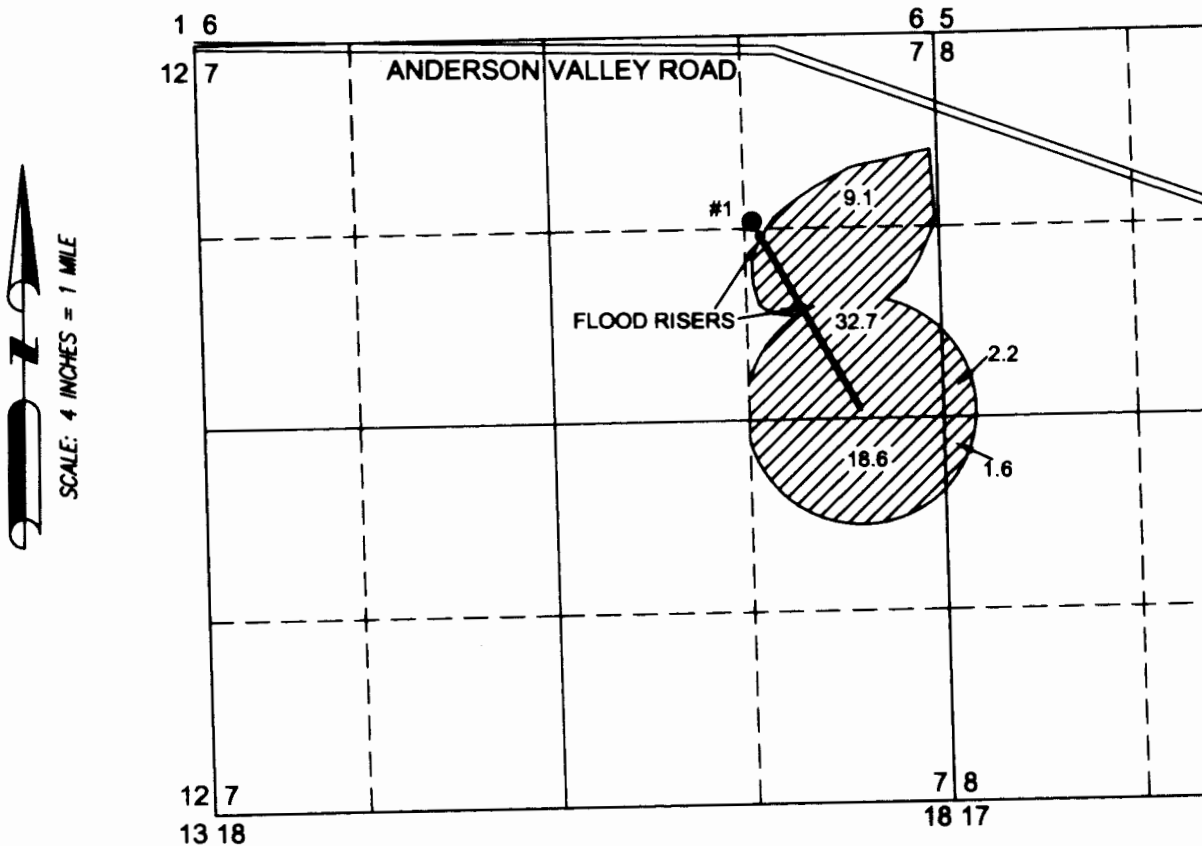

WELL (LAKE 51228)

- LOCATED IN THE NE 1/4 NE 1/4 SECTION 7, T27S R34E, W.M. AND 1290 FEET SOUTH AND 1240 FEET WEST FROM THE NE CORNER OF SAID SECTION.

FLOW METER IS LOCATED ON DELIVERY PIPE 5' SE FROM THE WELL.




64.2 ACRES PRIMARY RIGHTS FROM WELL (G-17216), AS SHOWN.



RENEWAL DATE: 12/31/2016

THIS MAP IS FOR THE PURPOSE OF LOCATING A WATER RIGHT ONLY AND HAS NO INTENT TO PROVIDE LEGAL DIMENSIONS OR THE LOCATION OF PROPERTY LINES.

<p>PREPARED FOR:</p> <p>STEVE HELMS 2874 MILLERSBURG RD NE ALBANY, OR 97321</p>	<p>PREPARED BY:</p>  <p>ALL POINTS ENGINEERING AND SURVEYING, INC. P.O. BOX 767 TERREBONNE, OR 97760 (541) 548-5833 www.APEandS.com</p>
--	--