


RECEIVED
 JUN 27 2003
 WATER RESOURCES DEPT
 SALEM, OREGON

See Map 6N 35 24B

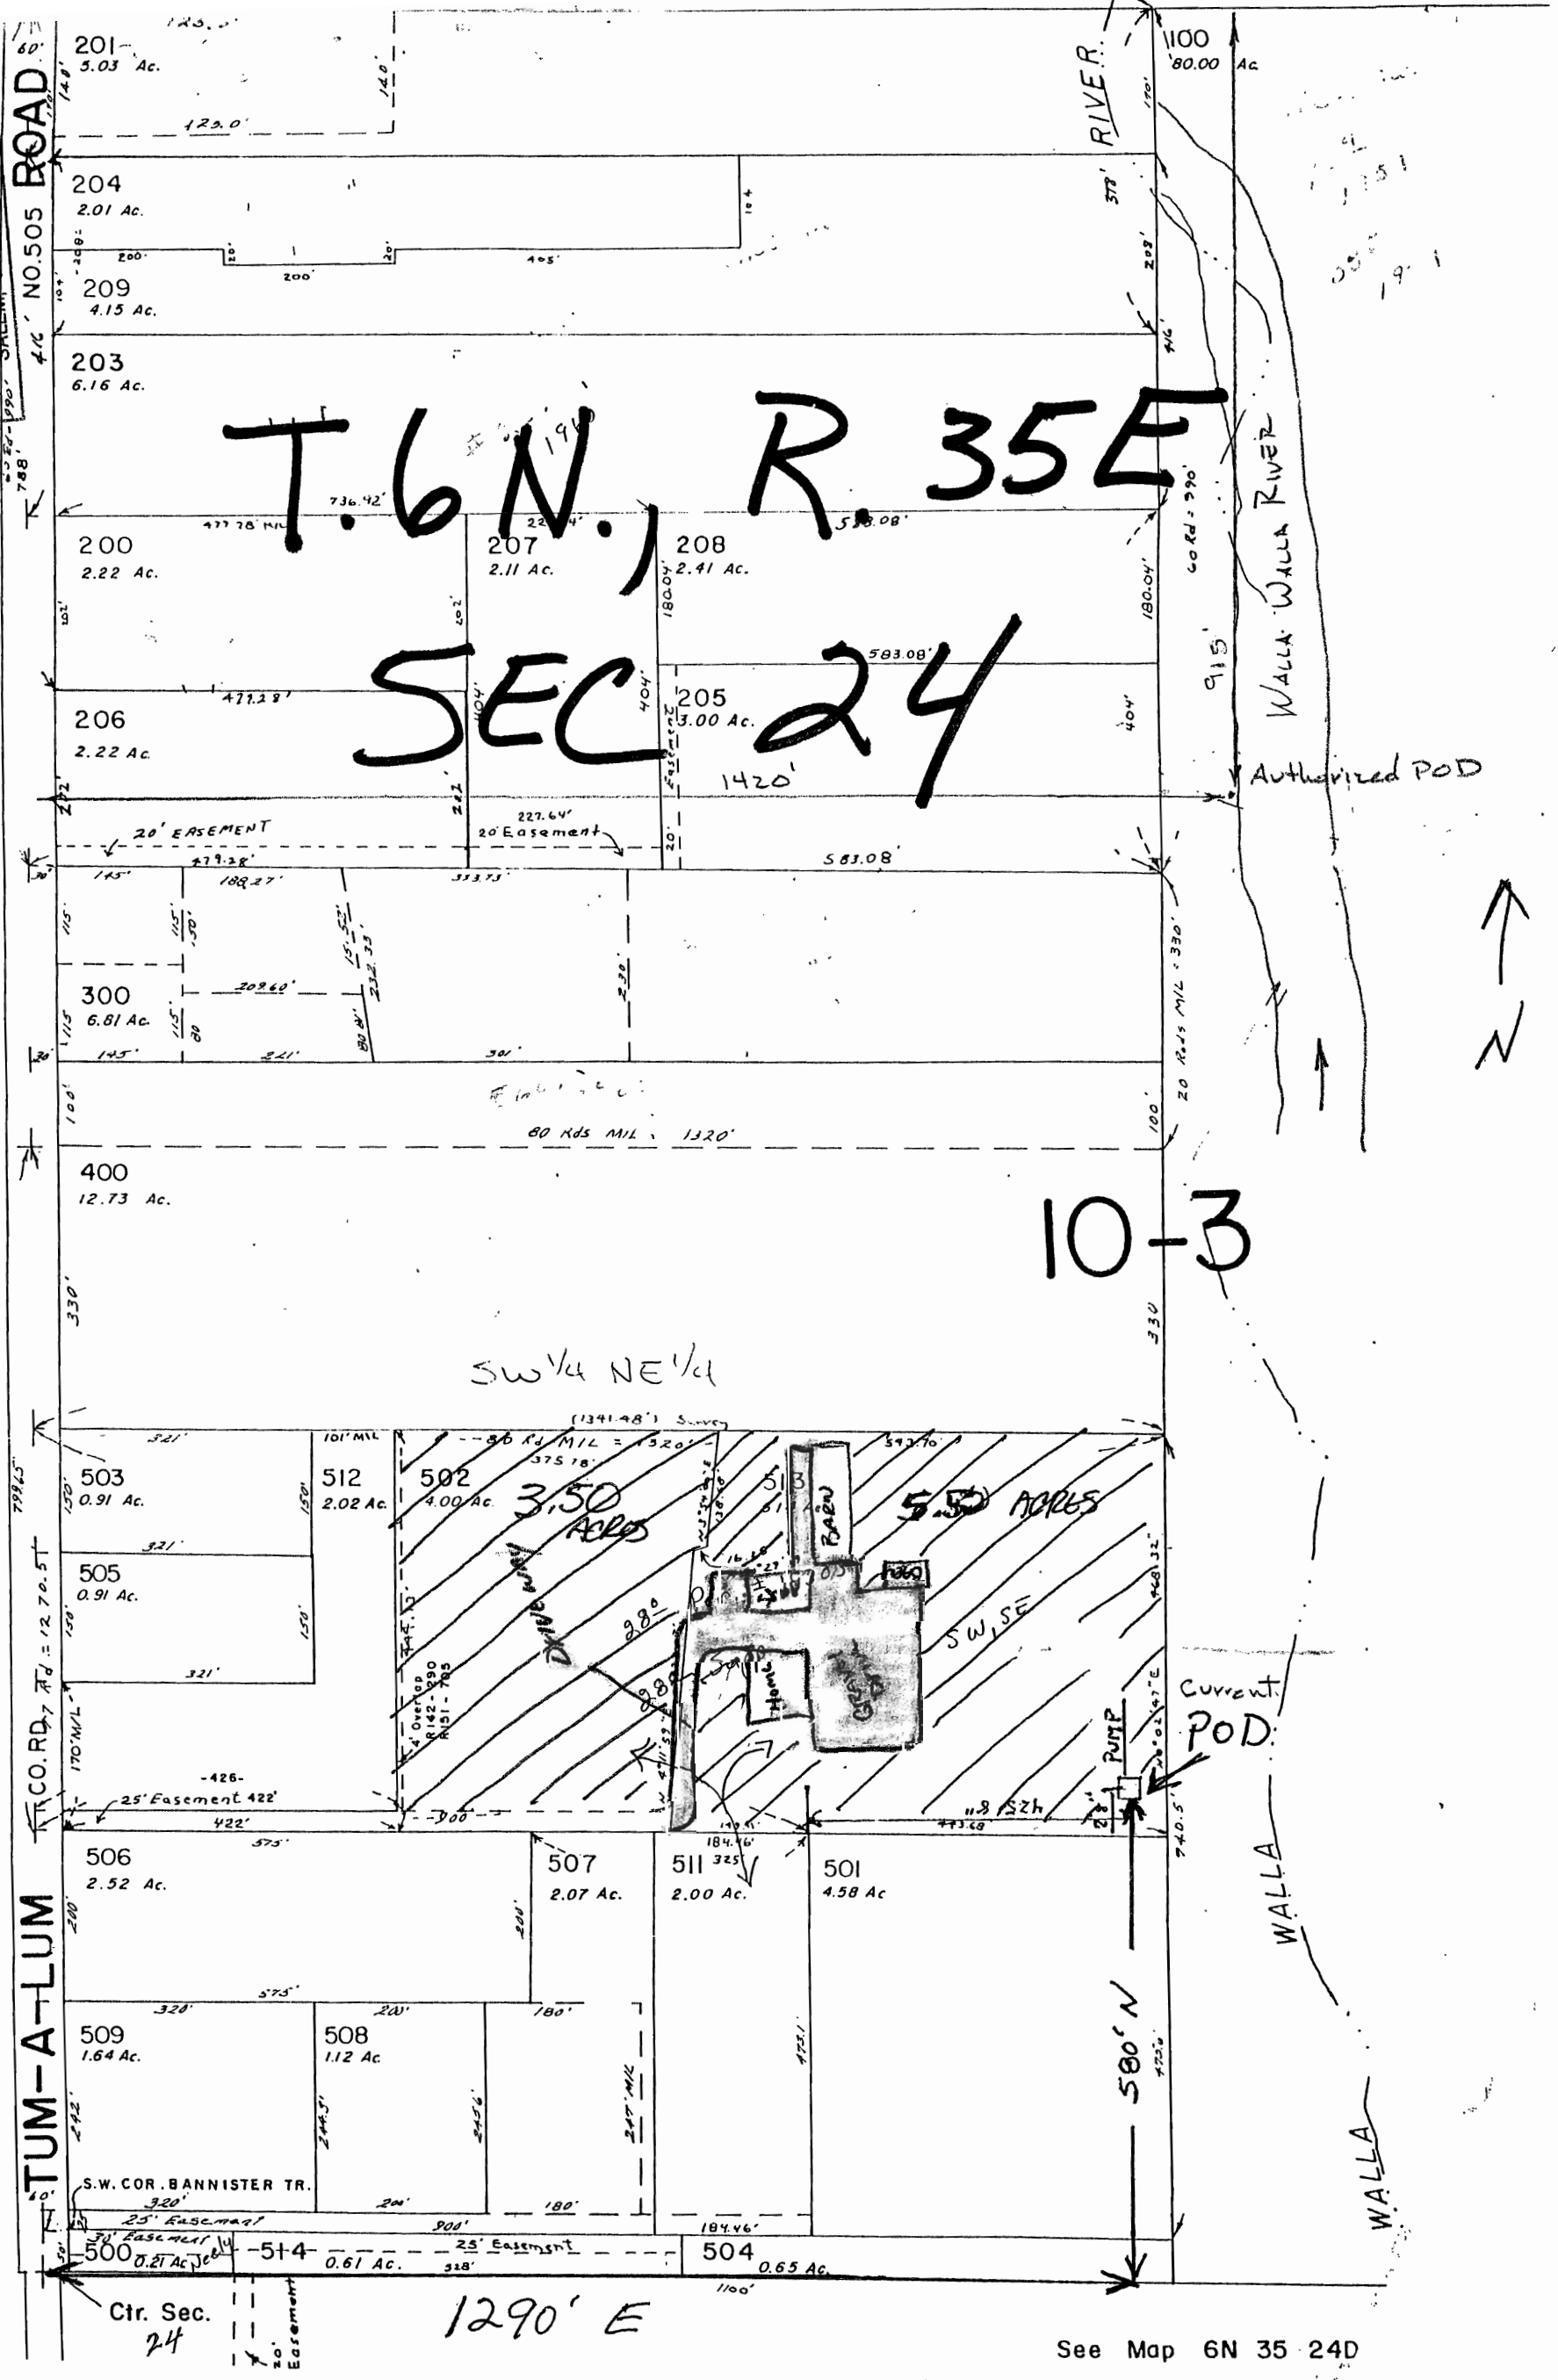

See Map 6N 35 24D

SCALE 1" = 200' T-9481

Jane Mauer 12/16/03
 Jane Mauer 12/16/03

Ronald Cole Roberts 12-16-03
 Devin Dymna Roberts 12-16-03