


# T. 37 S., R. 2 W., W. M.

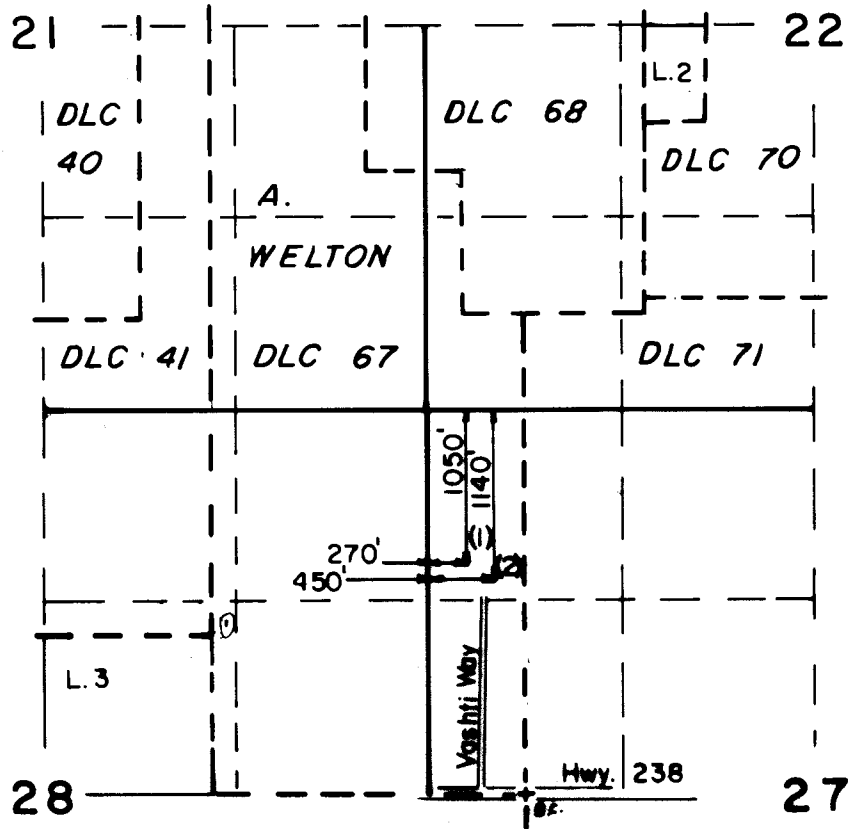

Scale: 1" = 1320'

## FINAL PROOF SURVEY UNDER


TRANSFER NO. 5842  
Application No. .... Permit No. ....  
IN NAME OF

EVERETT EVENSON

Surveyed APR. 17. 19.91., by L. M. JOACHIMS

T-5842

# T.37S.R.2W.W.M.

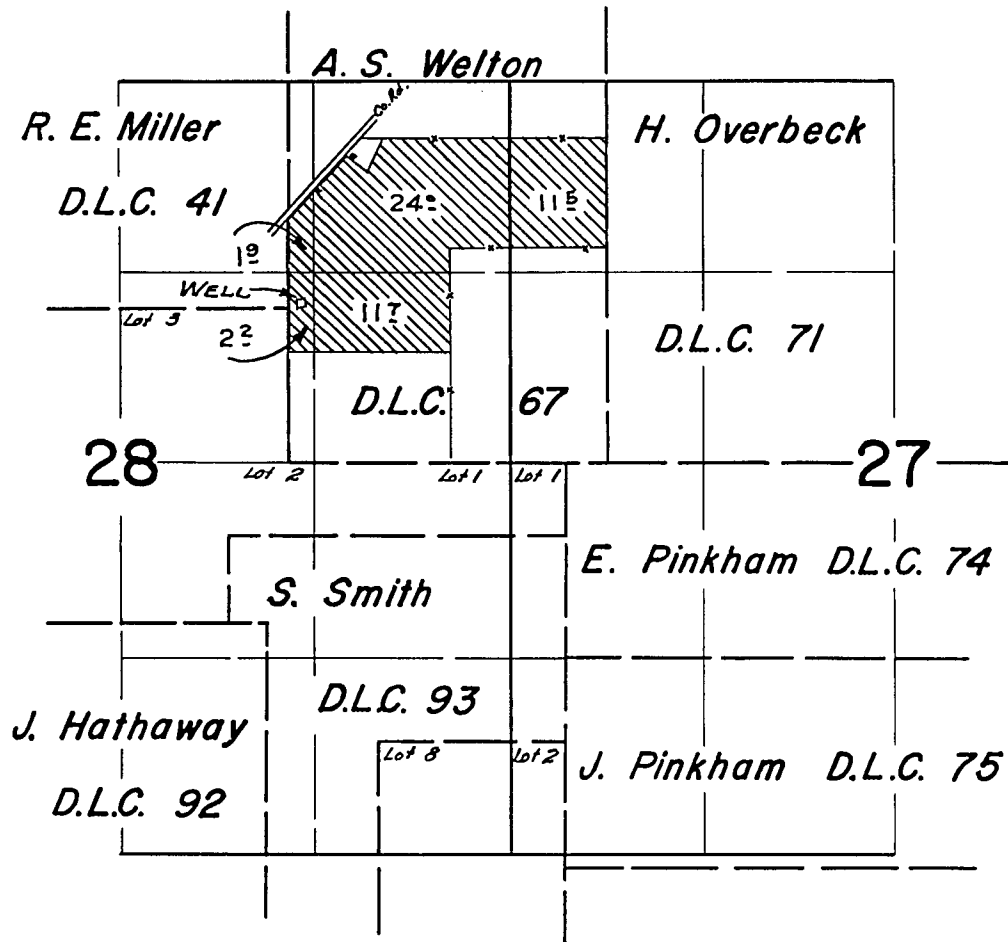

## FINAL PROOF SURVEY UNDER

Application No. G-1533 Permit No. G-1421  
IN NAME OF

E.E. & ELLA MAE MCGREW

Surveyed May 14, 1963, by *[Signature]*