


T. 37 S., R. 2 W., W. M.

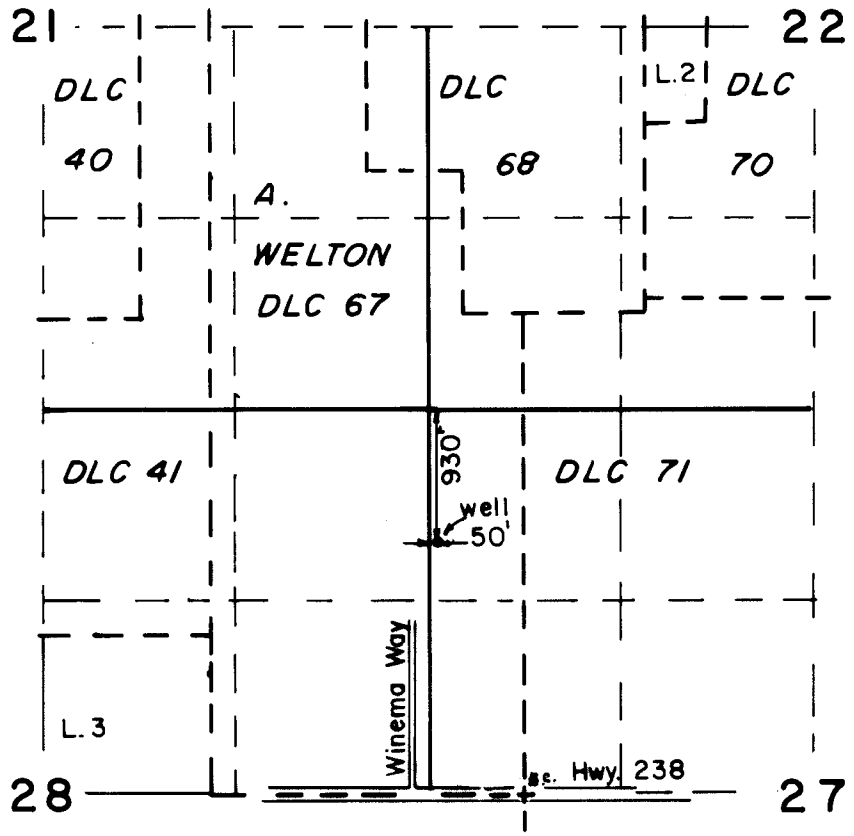

Scale: 1" = 1320'


FINAL PROOF SURVEY UNDER

TRANSFER NO. 5960
Application No. Permit No.
IN NAME OF

.....GLENN & DAWN LOWE.....

Surveyed APR..17.. 1991.., by L..M.. JOACHIMS.

T.37S.R.2W.W.M.

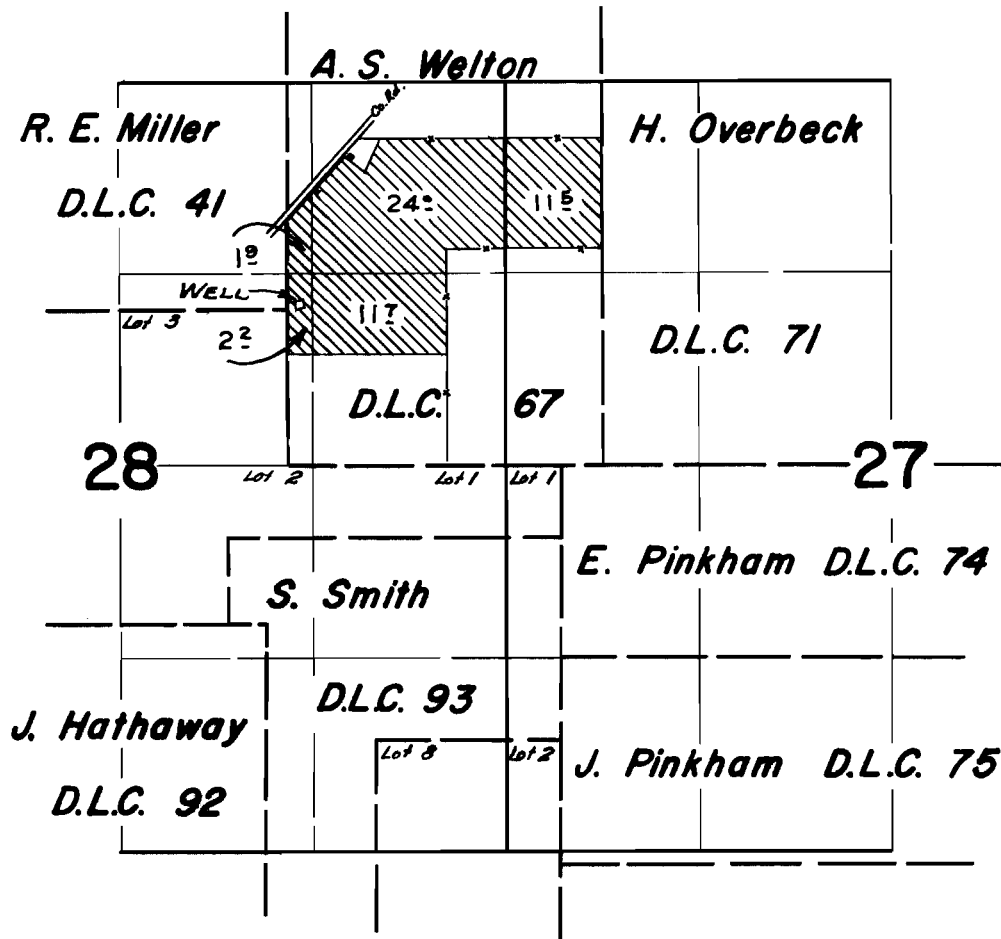

FINAL PROOF SURVEY
UNDER

Application No. 6-1533 Permit No. 6-1421
IN NAME OF

E. E. & ELLA MAE MCGREW

Surveyed May 14, 1963, by