

# T.36S.,R.2E.,W.M.

RECEIVED

SEP - 4 1997


WATER RESOURCES DEPT  
SALEM, OREGON



SCALE 1" = 1320'

## Chart of Existing Structures being Furnished Water by Lake Creek Domestic Water System

- |                    |                 |
|--------------------|-----------------|
| 1. Fire Station    | 7. Residence    |
| 2. Store           | 8. Residence    |
| 3. Residence       | 9. Residence    |
| 4. Community Bldg. | 10. Barn        |
| 5. Residence       | 11. Grange Hall |
| 6. Barn            | 12. Residence   |

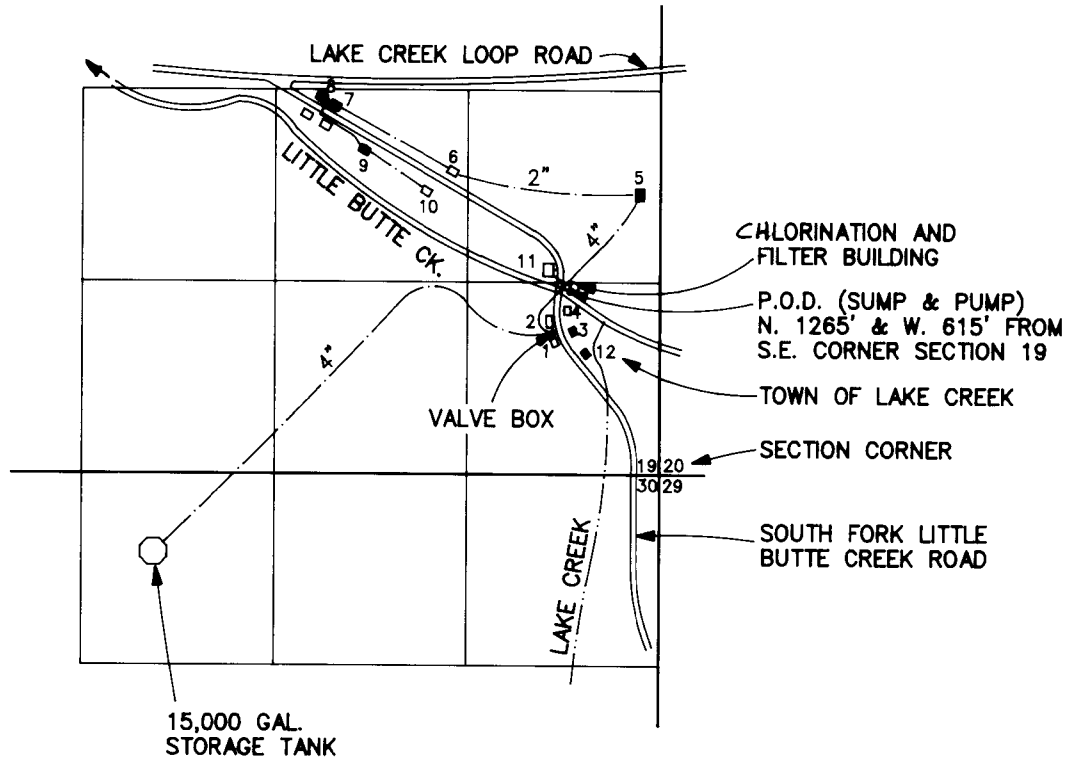

FINAL PROOF MAP  
APPLICATION No. T-7383

NOTE: MAP PREPARED FOR  
WATER RIGHT PURPOSES ONLY,  
NOT FOR PROPERTY BOUNDARY  
LOCATIONS.

IN THE NAME OF  
CASCADE RANCH

MAP PREPARED AUGUST 28, 1997 BY GARY D. KAISER

