

T.36S.,R.2E.,W.M.

RECEIVED

SEP - 4 1997


WATER RESOURCES DEPT.
SALEM, OREGON



SCALE 1" = 1320'

Chart of Existing Structures being Furnished Water by Lake Creek Domestic Water System

- | | |
|--------------------|-----------------|
| 1. Fire Station | 7. Residence |
| 2. Store | 8. Residence |
| 3. Residence | 9. Residence |
| 4. Community Bldg. | 10. Barn |
| 5. Residence | 11. Grange Hall |
| 6. Barn | 12. Residence |

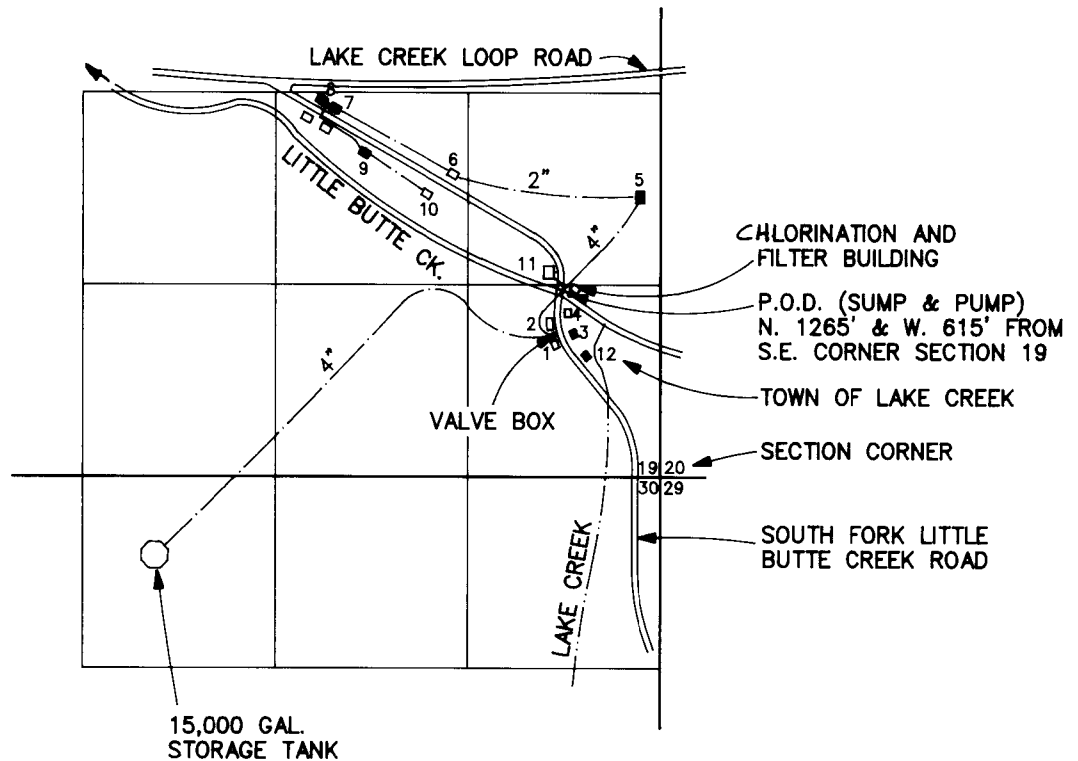

FINAL PROOF MAP
APPLICATION No. T-7383

NOTE: MAP PREPARED FOR
WATER RIGHT PURPOSES ONLY,
NOT FOR PROPERTY BOUNDARY
LOCATIONS.

IN THE NAME OF
CASCADE RANCH

MAP PREPARED AUGUST 28, 1997 BY GARY D. KAISER

