


Sec 33

Tp 7S.

R 2W.

Prop 9650

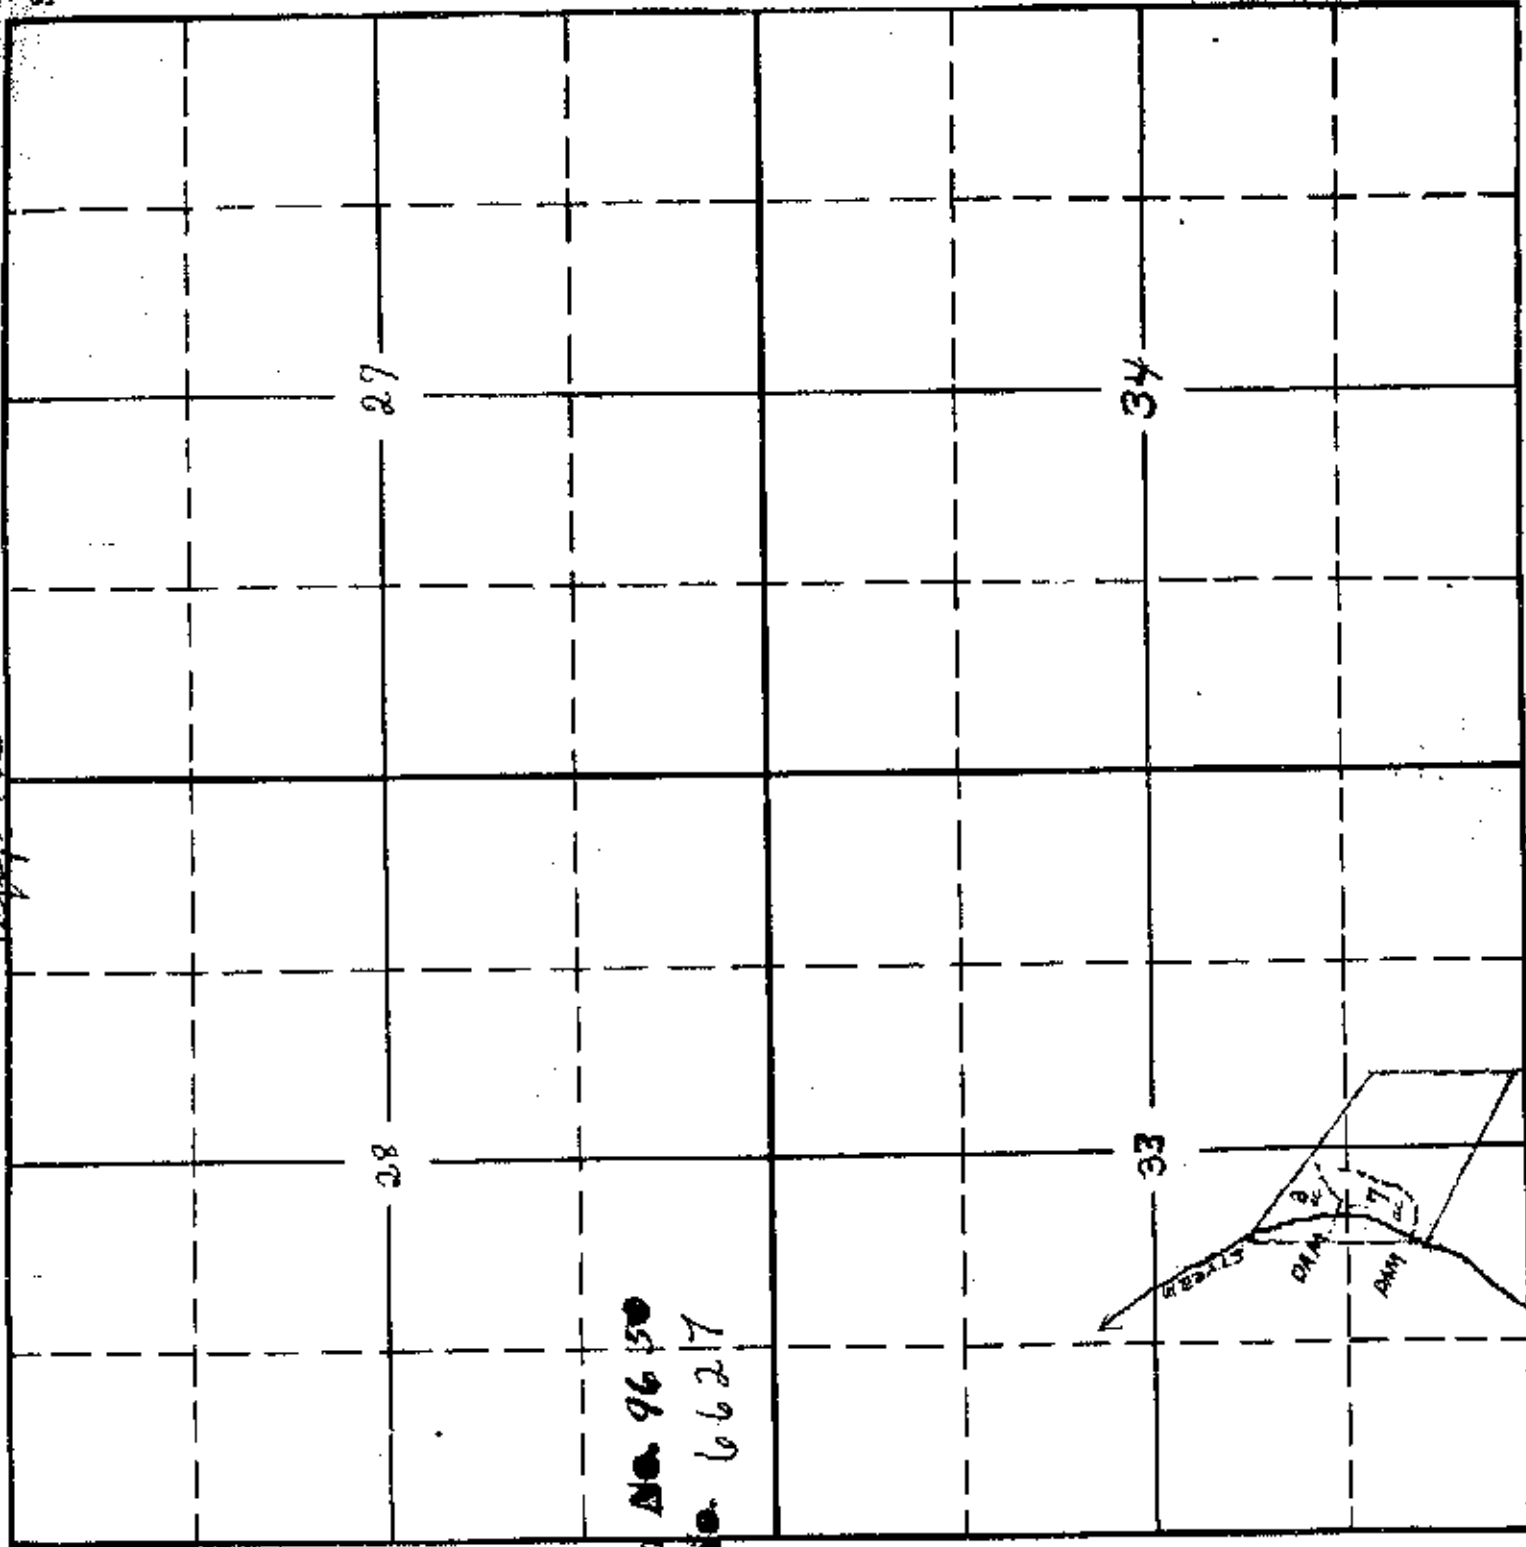

Application No. 9650  
 Permit No. 6627