


**Claim of Beneficial Use for
Application R-84832 - Permit R-13368
Leslie and Aldeana Stuart
SW 1/4 NE 1/4 Sec. 4 T.27S. R.7W.
Douglas County
1" = 500'**

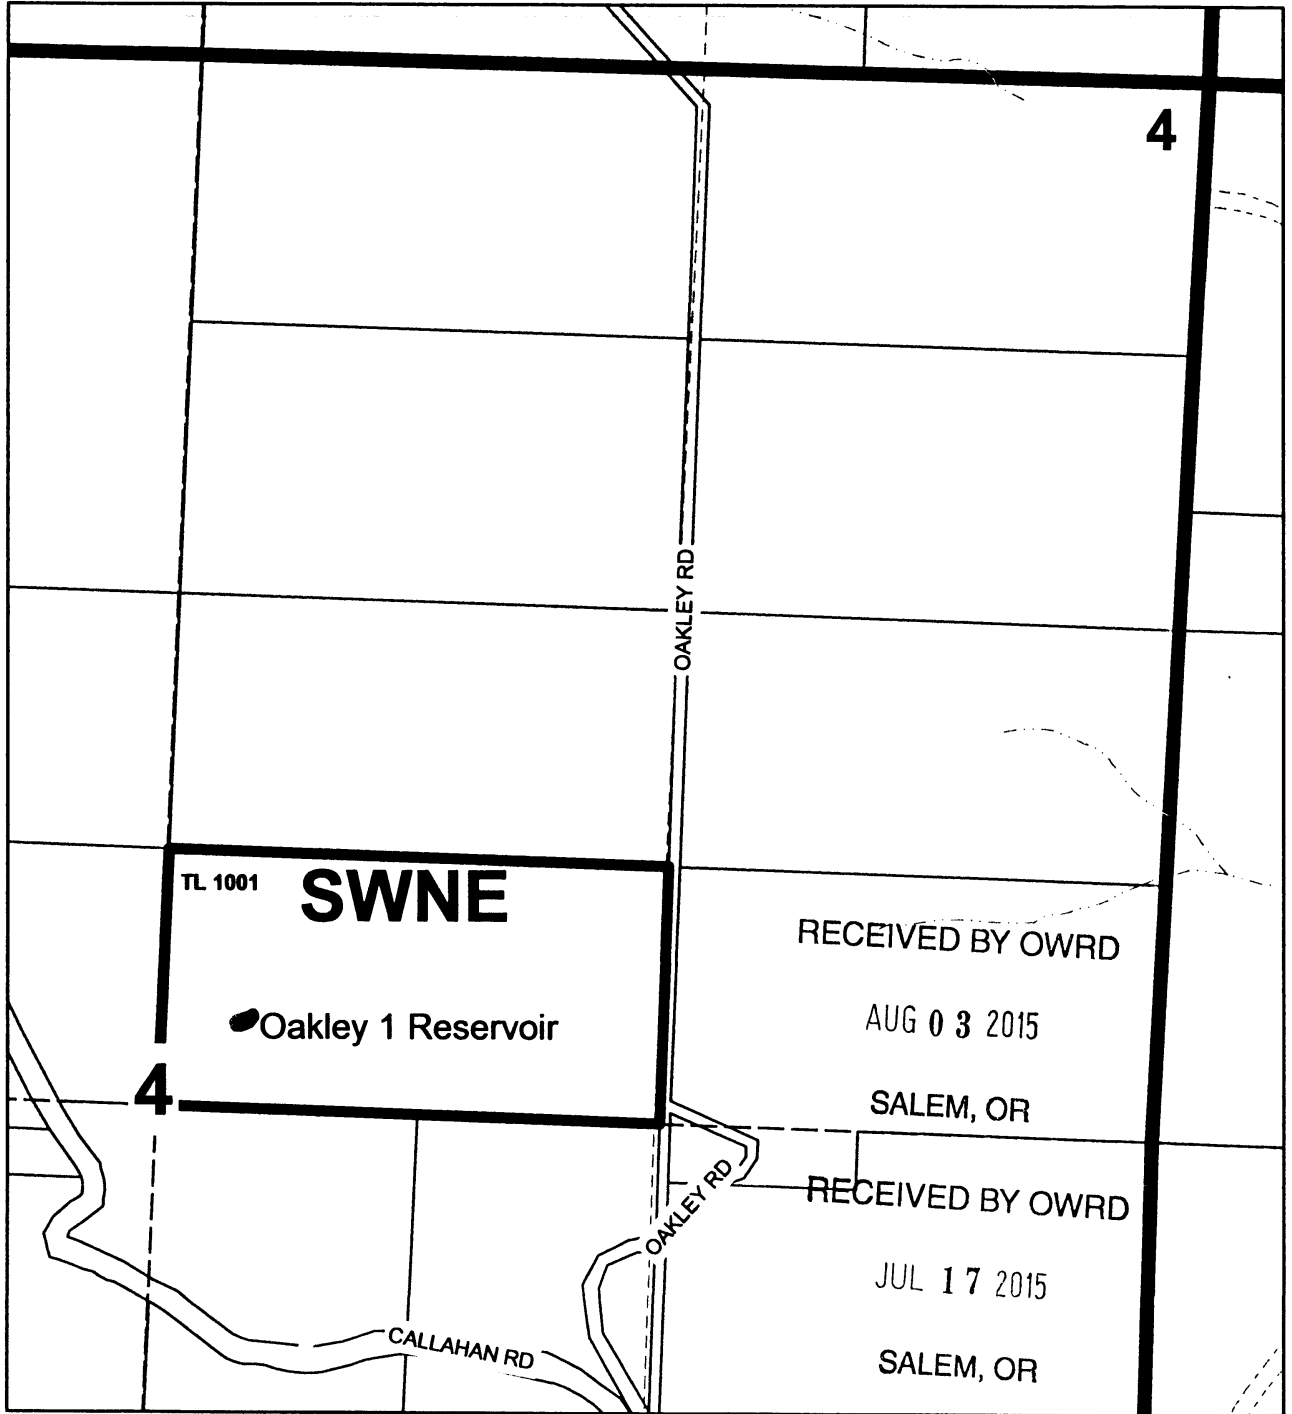

**Pond is located 2500' South and 2400' West from the
Northeast corner of Section 4.**