

POD APPROX 2000' WEST, 1730' NORTH
FROM SE CORNER SEC 11, T15S, R43E

POND AS CONSTRUCTED IS A NON-CONSUMPTIVE
USE WITH CONTINUOUS FLOW THROUGH IT.
IT IS USED FOR WILDLIFE ENHANCEMENT




1" = 1320'
T15S R43E W.M.

RECEIVED BY OWRD

JUL 27 2015

SALEM, OR

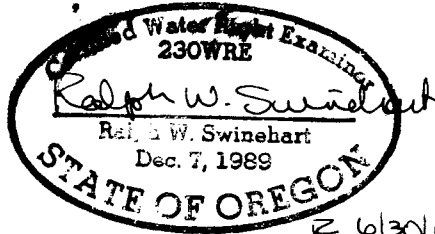

26/30/16

THIS MAP IS PREPARED FOR WATER
RIGHT PURPOSES ONLY AND SHOULD
NOT BE USED FOR PROPERTY
LOCATION PURPOSES.

FINAL PROOF MAP
PERMIT R-12768
SECTION 11, T15S, R43E
WALLOWA COUNTY

FOR: GEORGE D. McDANIEL
78145 WADE GULCH LANE
LOSTINE, OREGON 97857
JULY 2015

PREPARED BY: WALLOWA MOUNTAIN ENGINEERING