

100 R-84353
R-84353

RECEIVED
MAR - 1 2000
WATER RESOURCES DEPT
SALEM, OR


RECEIVED BY OWRD

FEB 20 2015

SALEM, OR

SEE MAP NO 862

SCALE 1:9600

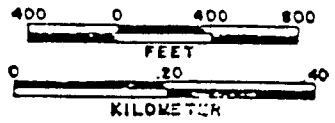

SCALE 1"=800' POND #2


P.O.D Located 540'S + 1160' E of NW Corner + section 1

SEC. 1 T8SR6WWM
POLK COUNTY

SCALE 1"=400'

Proposed place of use
 Proposed place of use
 section corner
 quarter corner

861

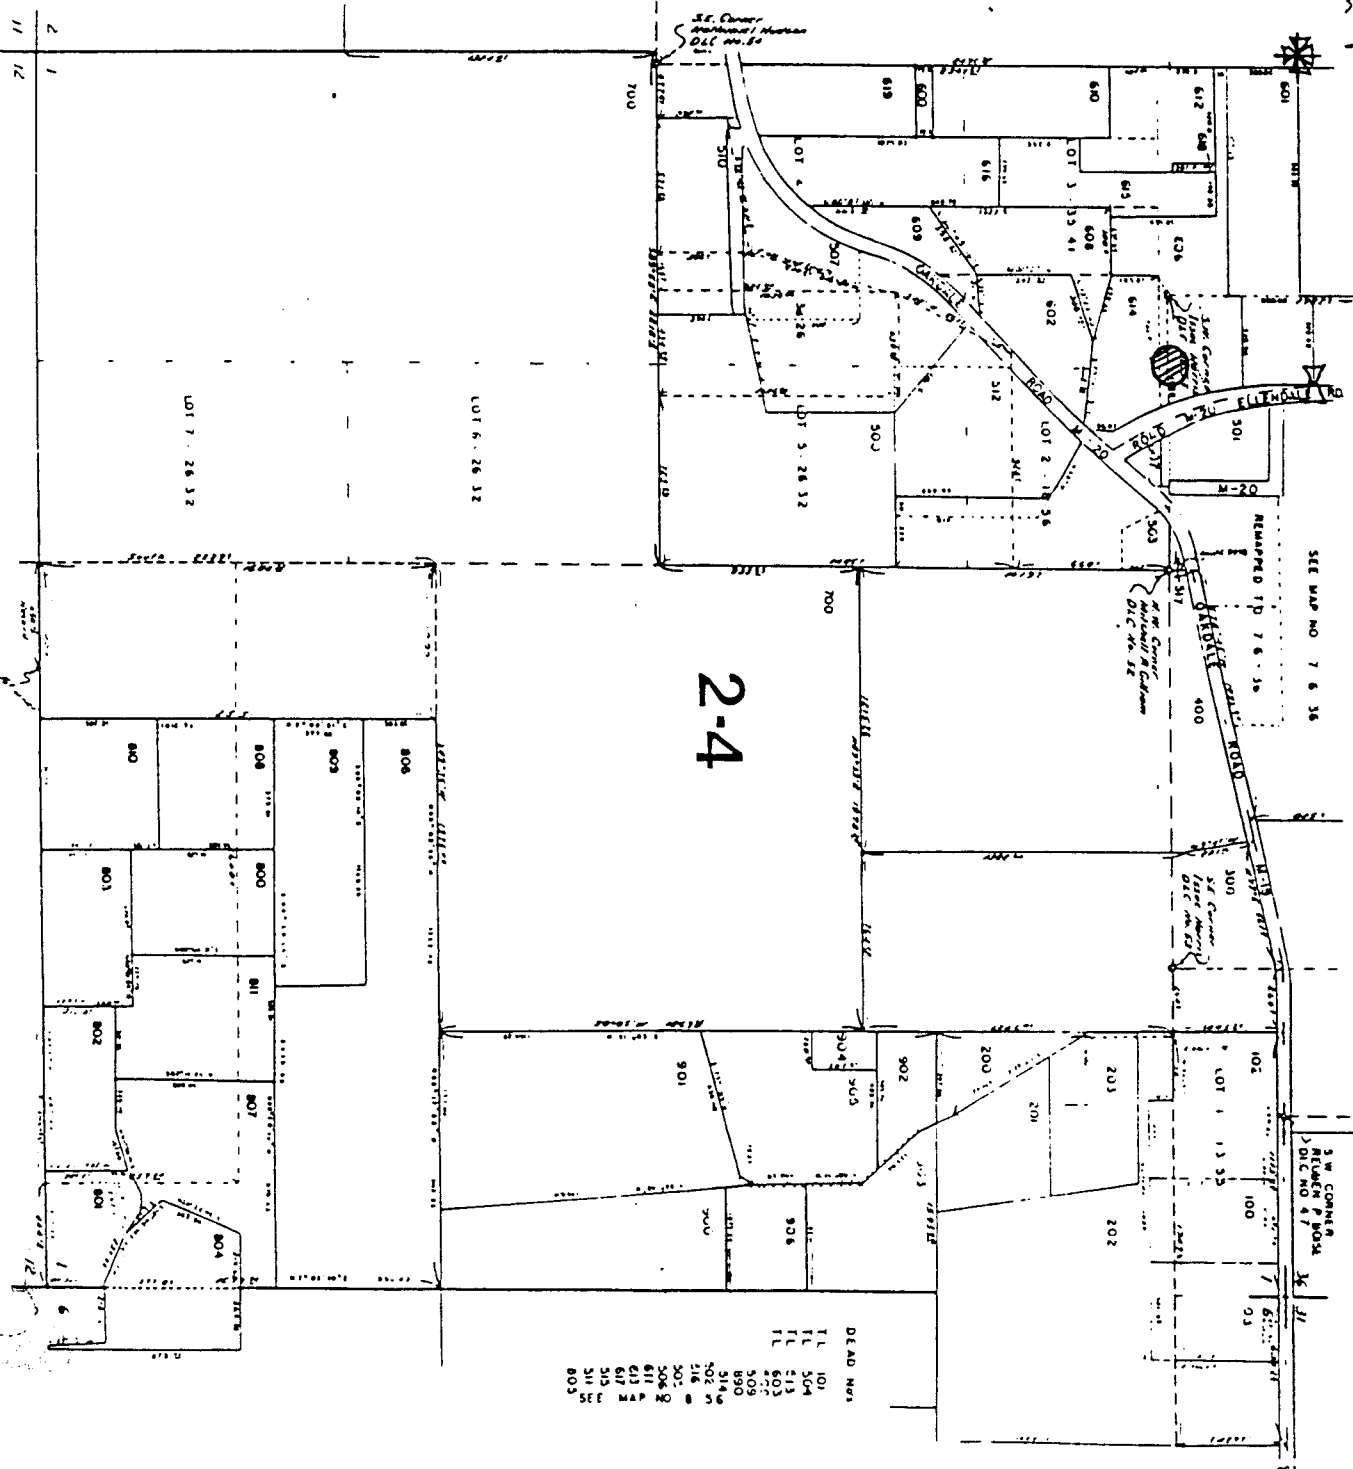

DEAD NPS

TL	101
TL	104
TL	113
TL	114
Application # updated by Dept. *mfb*/wrd 5-24-16 / Measured distance directional updated to 1160 Feet East. *mfb*