

Plat Map

28323 TAMPICO ROAD
COUNTY BENTON
State OR Zip Code 97330

This is the map
that you sent to us
submitted by the
previous owners.

The size is
180' x 100' x 5'
by our measurement.


Application #
R-84223

Permit # R-12763

RECEIVED BY OWRD

JUN 08 2015

SALEM, OR

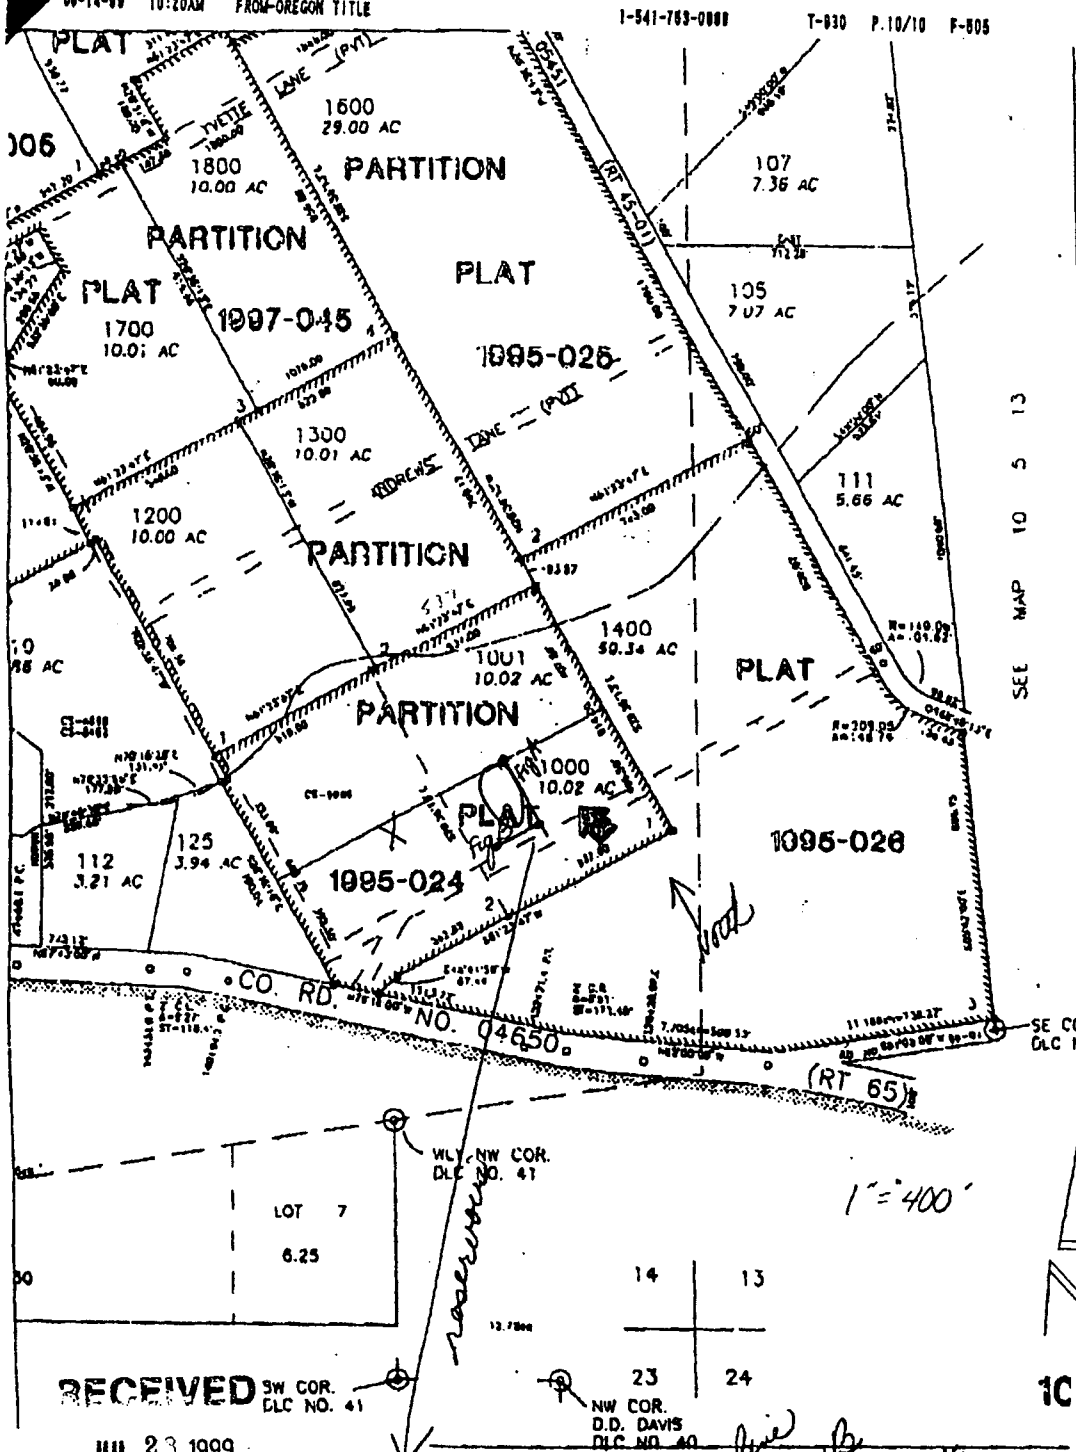

RECEIVED SW COR.
CLC NO. 41

JUL 23 1999

WATER RESOURCES DEPT.
SALEM, OREGON

Application No. 84223
Permit No. R-12763

200' running
Back of
8' in front
property line
figure B
108' running
east about
311 feet
from
survey
line