


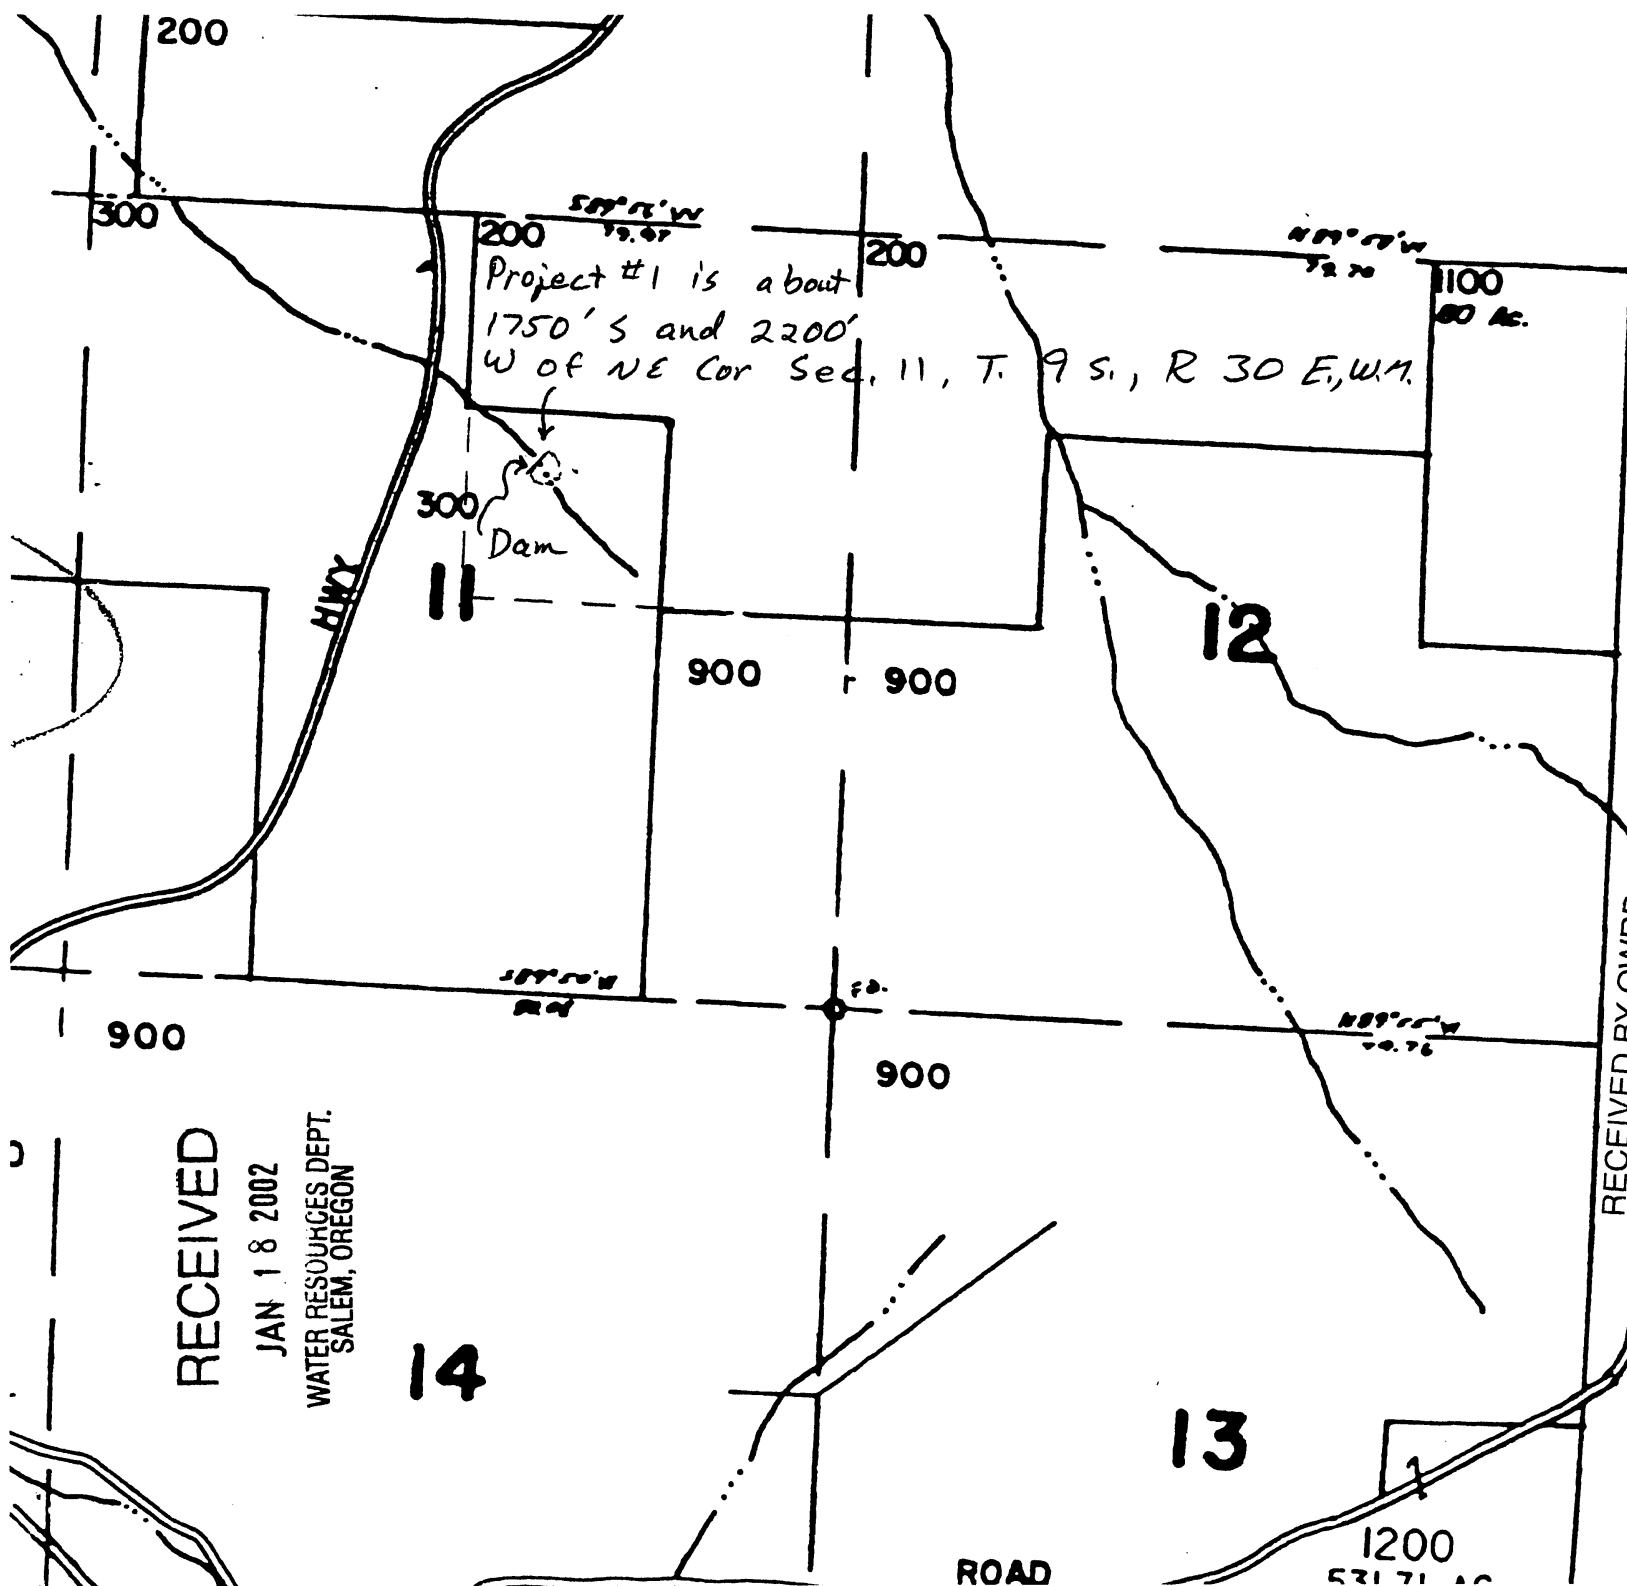

T 9 S., R. 30 E., W.M.
Scale 4" = 1 mile



Dead No
1000

Application No. R-85605
Permit No. R-13314

RECEIVED BY OWRD

JUL 13 2015

SALEM, OR

James N. Cannon

RECEIVED

JAN 18 2002

WATER RESOURCES DEPT.
SALEM, OREGON

ROAD