

RECEIVED BY OWRD

JUL 10 2015

SALEM, OR

WORKING COPY



39S 5W
Section


SUBJECT
PROPERTY

SCALE
1" = 300'

RECEIVED BY OWRD

JUL 23 2015

SALEM, OR

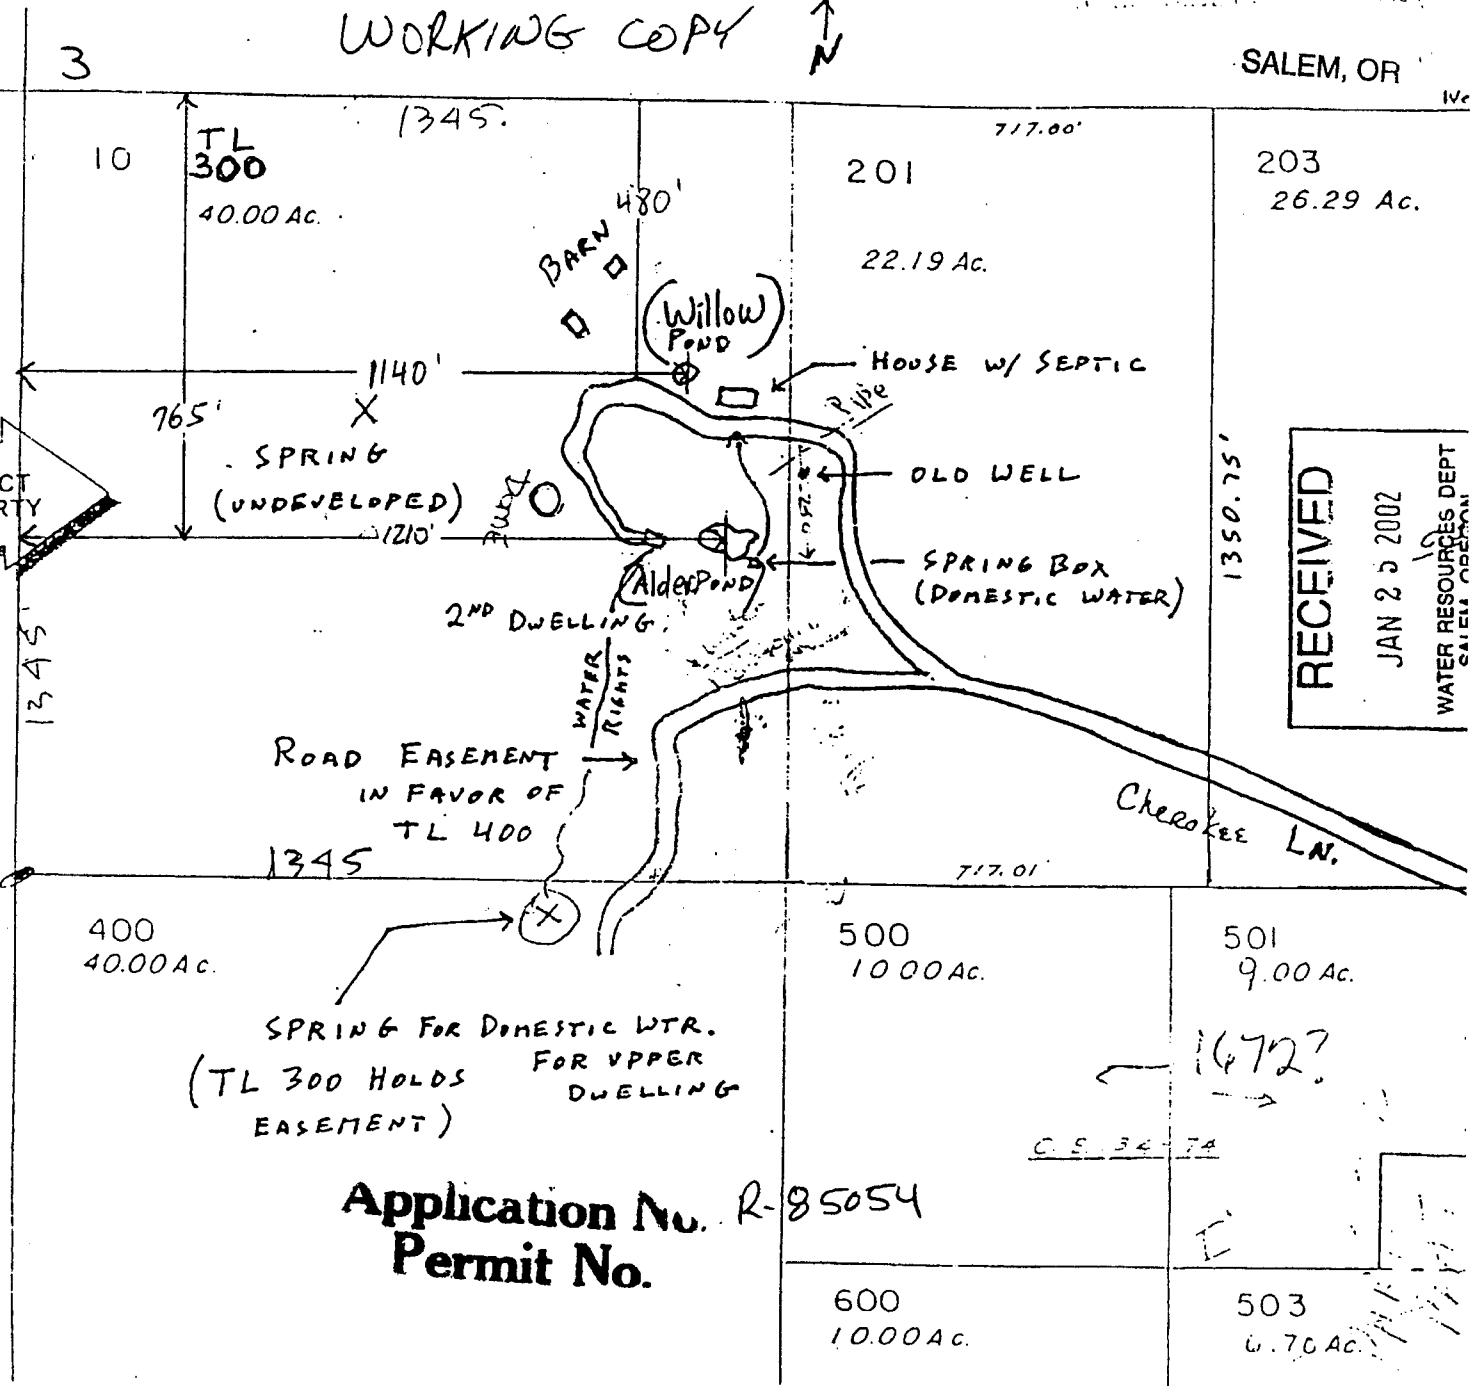

RECEIVED

JAN 23 2002

WATER RESOURCES DEPT
SALEM, OREGON

Application No. R-85054
Permit No.