


T14S R6W  
SECTION 14 T14S R6W WM  
BENTON COUNTY

THIS MAP WAS PREPARED FOR ASSESSMENT PURPOSES ONLY

14 7  

RECEIVED  
JAN 24 2005  
WATER RESOURCES DEPT  
SALEM, OREGON

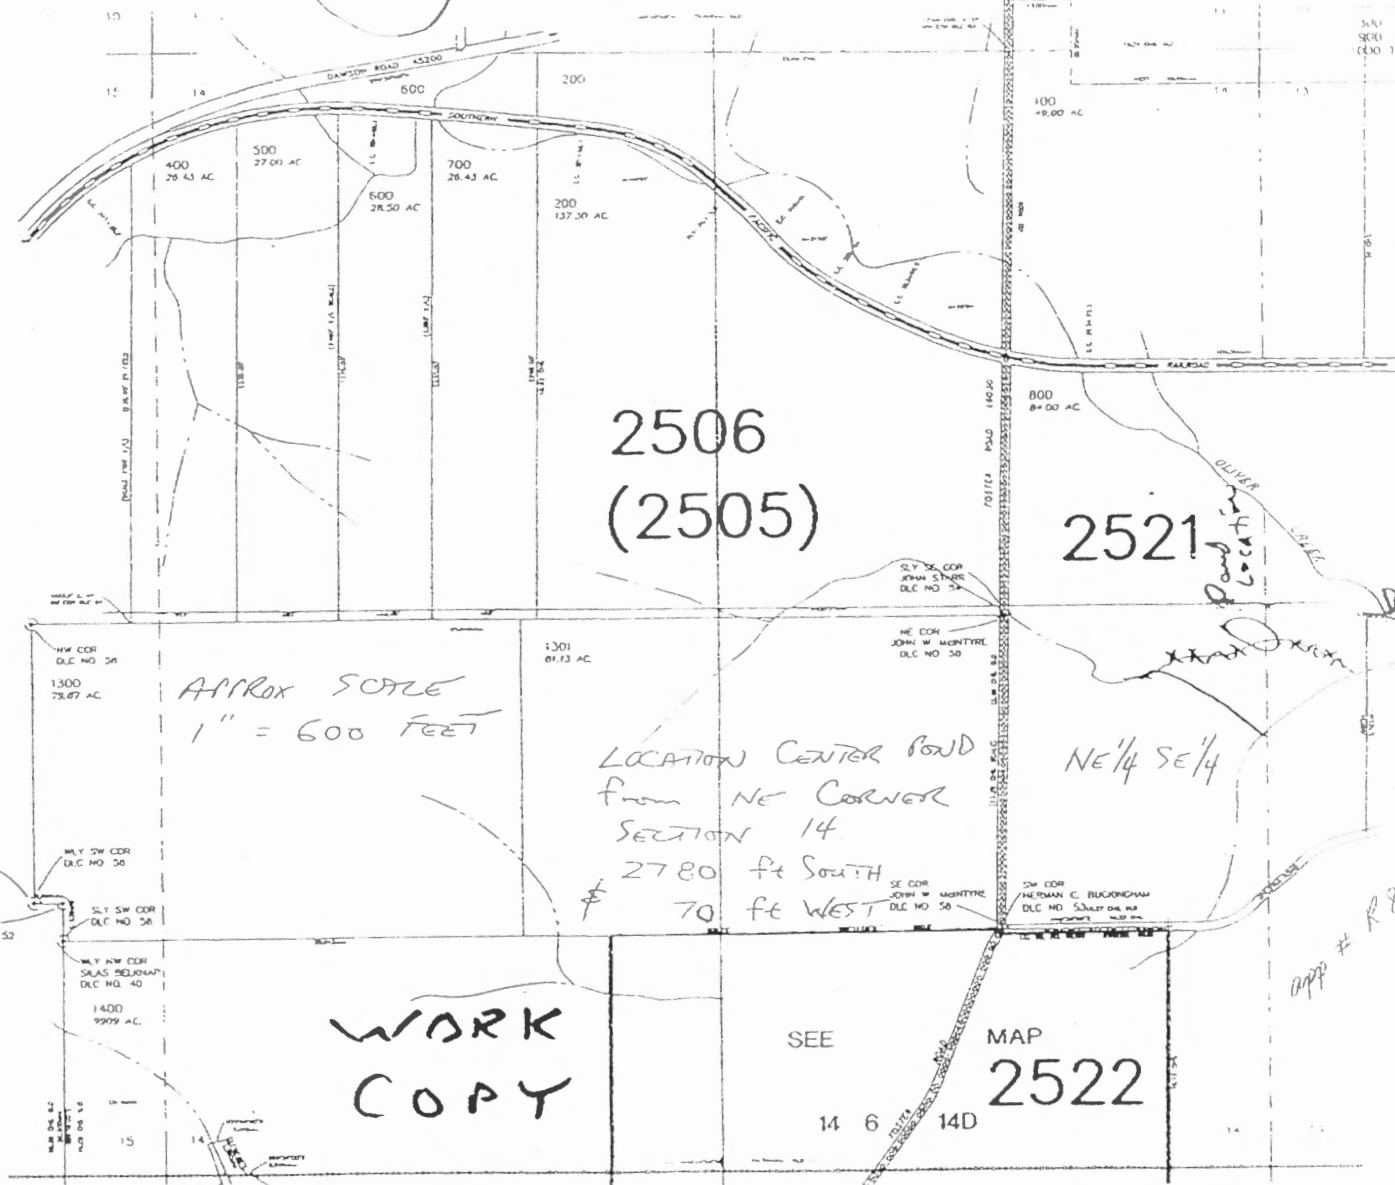

SEE MAP 14 8 15

APPROX SCALE  
1" = 600 FEET

LOCATION CENTER POND  
FROM NE CORNER  
SECTION 14

2780 ft SOUTH  
70 ft WEST

WORK  
COPY

SEE MAP  
14 6 14D  
2522

Reference Point

\*\*\* INCORRECT SEASONAL STREAM LOCATION

Correct Seasonal Stream Location  
SALEM, OR Pond Location - SW 1/4 NE 1/4 SW 1/4 S13 T14S R6W  
TAX LOT # 188395

RECEIVED BY OWRD

AUG 27 2015