


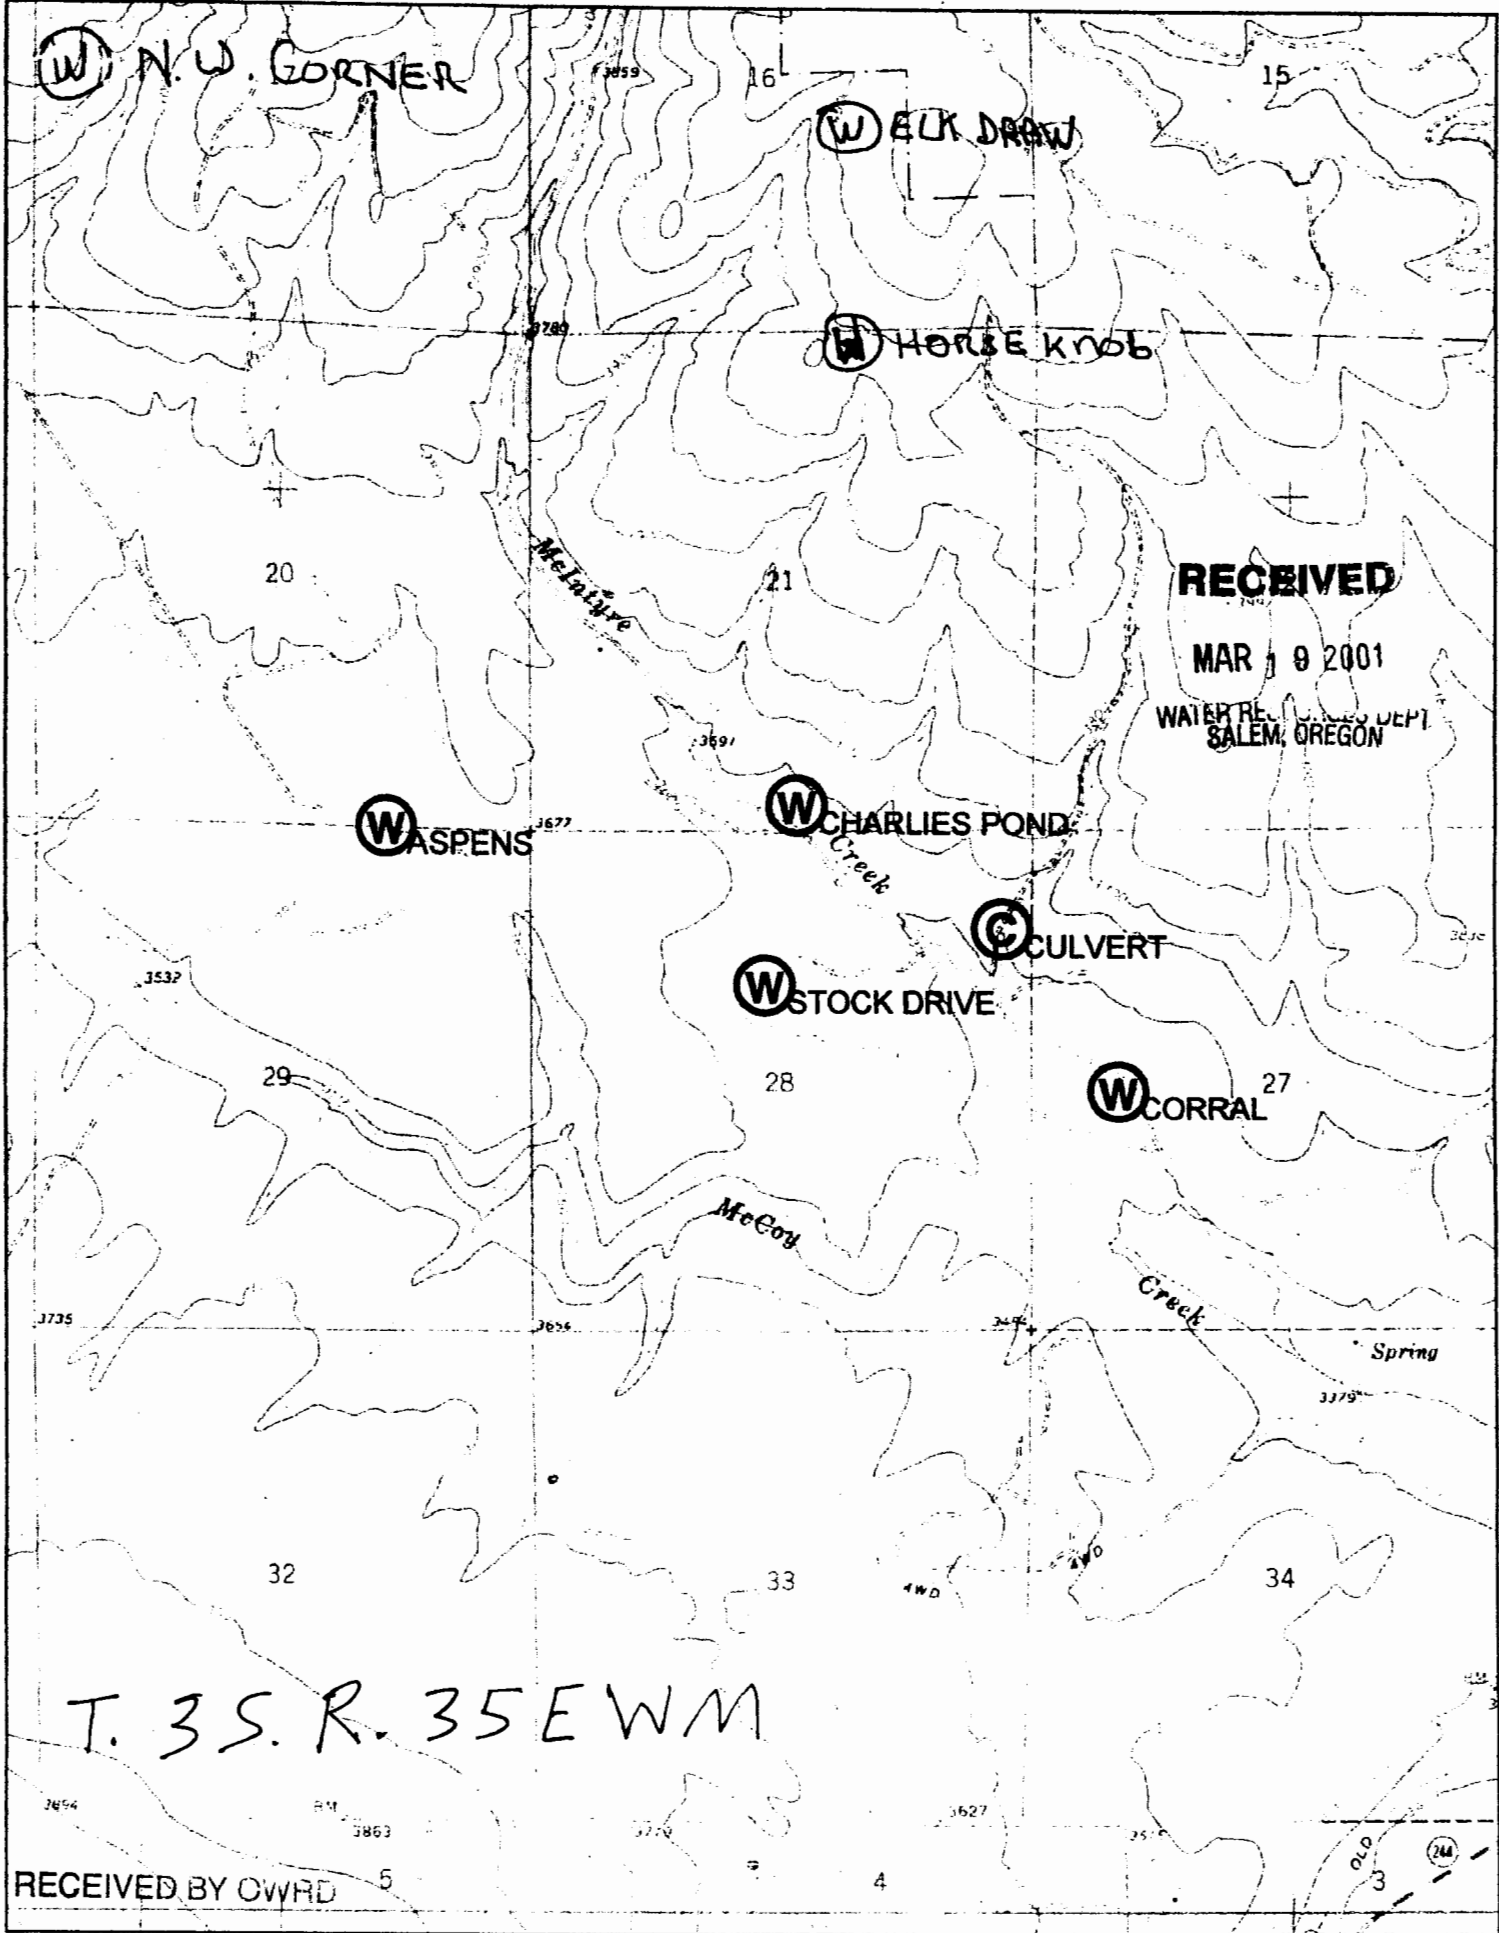

RECEIVED

MAR 9 2001

WATER RESOURCES DEPT.
SALEM, OREGON

W ASPENS

W CHARLIES POND

C CULVERT

W STOCK DRIVE

W CORRAL

T. 3 S. R. 35 E W M

RECEIVED BY CWRD

Copyright (C) 1997, Maptech, Inc.



JUL 30 2015

SALEM, OR

McGoy CK > Meadow > GR > Snake