


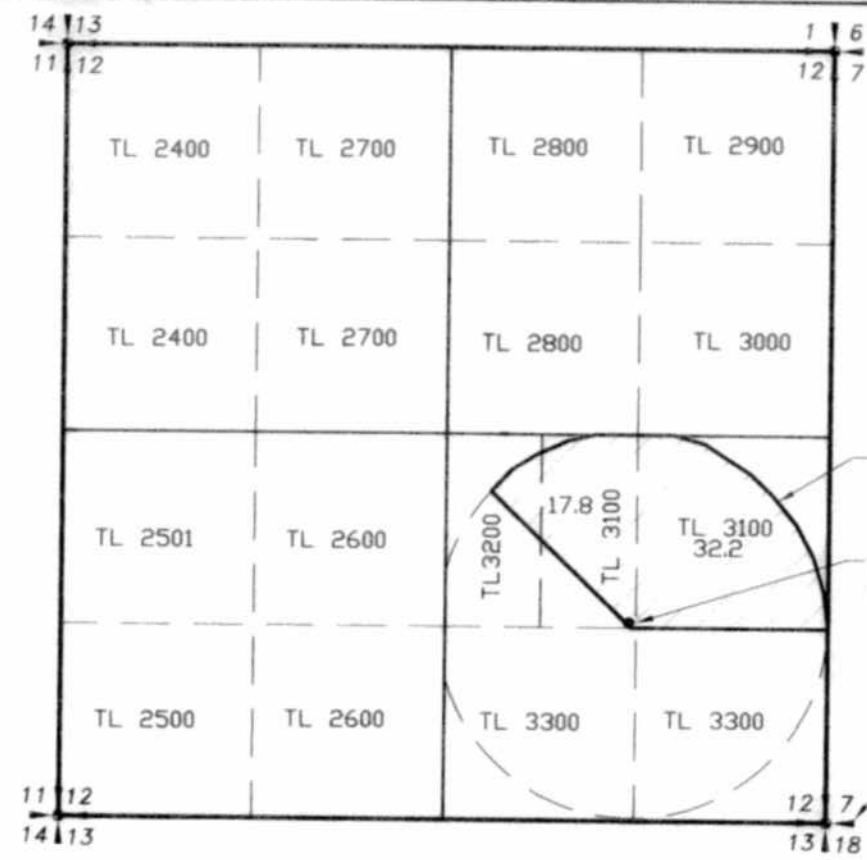

BOYLES
PIVOT

WELL #1 LOCATED 1356.23' NORTH
AND 1368.88' WEST OF THE
SOUTHEAST CORNER OF SECTION 12

FOUND SECTION CORNER
AND REFERENCE MARKER



8.6 ACRES TRANSFERRED FROM CERTIFICATE NO. 30882



2.4 ACRES TRANSFERRED FROM CERTIFICATE NO. 33048



4.4 ACRES TRANSFERRED FROM CERTIFICATE NO. 64011

WELL #2 LOCATED 1343.36' NORTH
AND 1318.43' WEST OF THE
SOUTHEAST CORNER OF SECTION 31

NOFZIGER
PIVOT

FOUND SECTION CORNER

CLAIM OF BENEFICIAL USE MAP


FOR

TERRY NOFZIGER

JOHN E. & NANCY C.

BOYLES TRUST

SECTIONS 12 AND 31,
TOWNSHIP 26 SOUTH RANGE 18 EAST,
LAKE COUNTY, OREGON

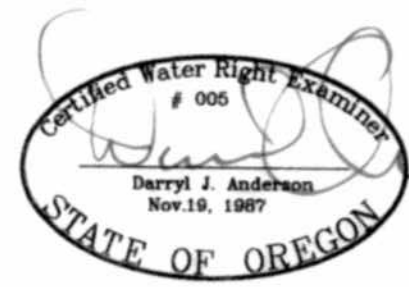

RENEWAL 12/31/07

LEGEND

- SECTION LINE
- 1/4 SECTION LINE
- 1/16 SECTION LINE
- IRRIGATED AREA

TRANSFER NO. T-8518

SCALE: 1"=1320'

SEP 13 2007

WATER RESOURCES DEPT
SALEM, OREGON

NOTE:
PREPARATION OF THIS MAP IS FOR IDENTIFYING PROPOSED
WATER RIGHTS ONLY. IT HAS NO INTENT TO PROVIDE
LOCATIONS OR DIMENSIONS OF PROPERTY BOUNDARIES.

This map has been amended by WRD to include the acreage amounts under each
certificate within the SE 1/4 SE 1/4 of Section 31, T 26 S, R 18 E, W.M. JOYE/WRD
6-14-10

COBU MAP # 0286

REVISION	BY

**ANDERSON ENGINEERING
AND SURVEYING, INC.**
P.O. BOX 28
LAKEVIEW, OREGON
97630 (541)
947-4407 FAX
947-2321

FOR:
TERRY NOFZIGER
P.O. BOX 586
CHRISTMAS VALLEY, OR 97641
(541) 408-2745

CLAIM OF BENEFICIAL USE
TRANSFER T-8518

DATE:	5/29/2007
SCALE:	1"=1320'
DWG. BY:	R.C.
JOB:	2004-066
FILE:	2004-066
SHEET:	1 OF 1