
FINAL PROOF MAP

FOR

T-6589 PERMITS 12000, 12001, 24144, 26136 & 7400

WARREN TAYLOR

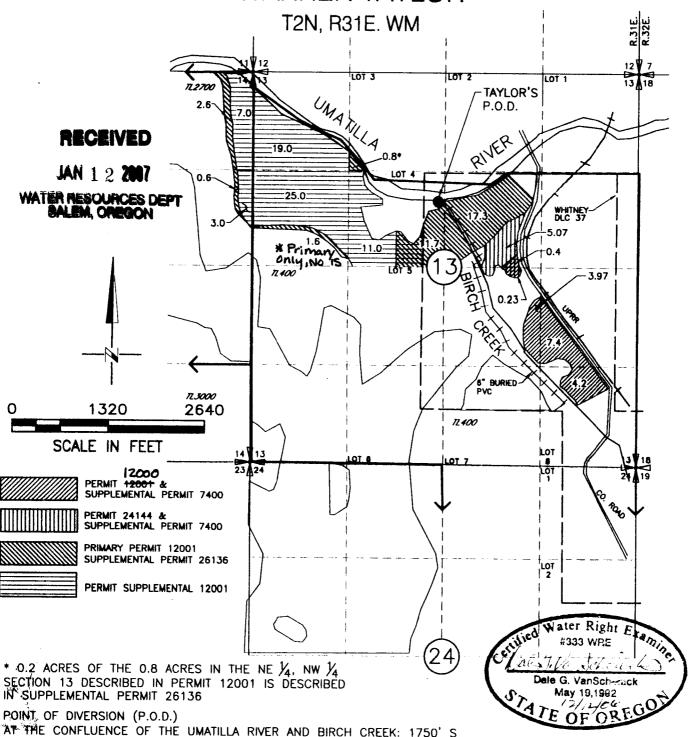

AND 2730' W FROM N.E. CORNER OF SECTION 13

This map was modified by OWRD - 745 6-15-16

THE PURPOSE OF THIS MAP IS TO IDENTIFY THE APPROXIMATE LOCATION OF THE WATER RIGHT. IT IS NOT INTENDED TO PROVIDE INFORMATION RELATIVE TO THE LOCATION OF PROPERTY OWNERSHIP BOUNDARY LINES.

DRAWING: H:\CAD\AG\3522\308\3522308\3522080CFP.dwg PRINTED BY: Roger.Willard on 12/12/06 03:29 PM

