


T.9S. R.5W. W.M.

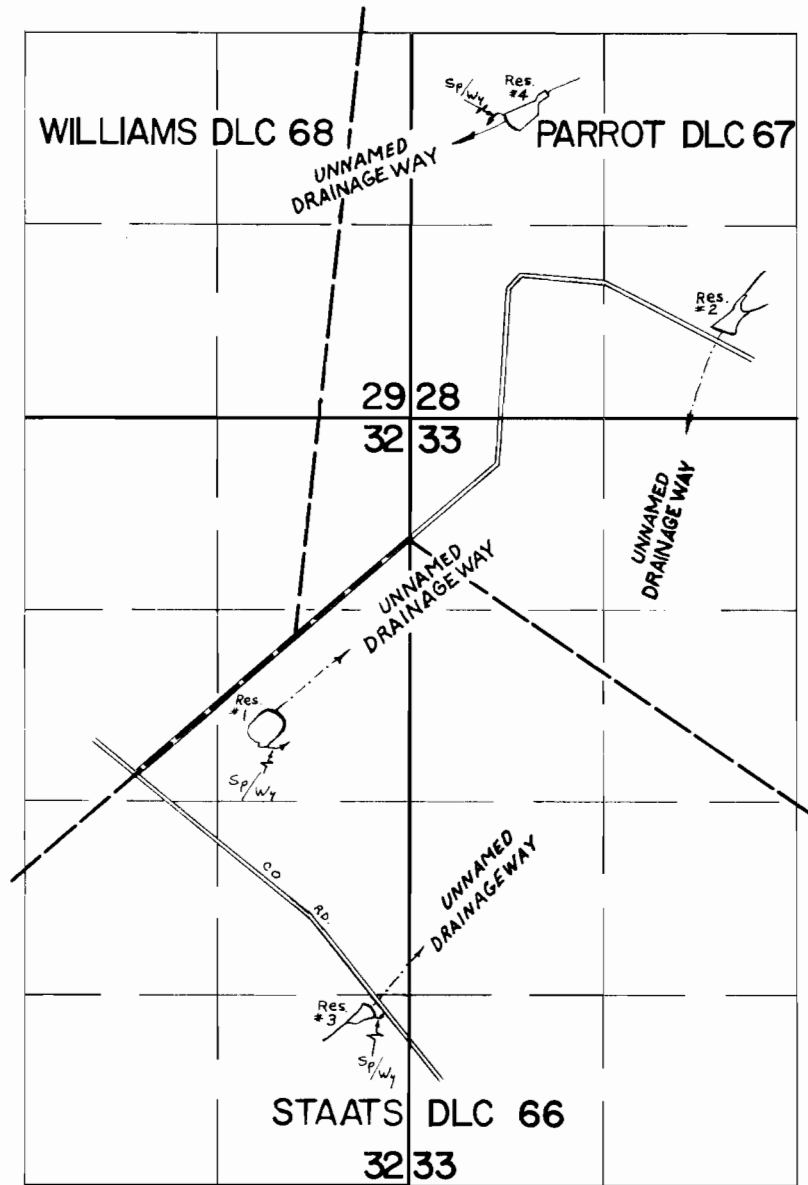

FINAL PROOF SURVEY
UNDER


Application No. R-46854 Permit No. R-5616
R-46855 R-5617
IN NAME OF

LOUIS HAMILTON

Surveyed MARCH 15, 1973, by R. MUCKEN

T9S & T10S, R5W, WM

POLK COUNTY

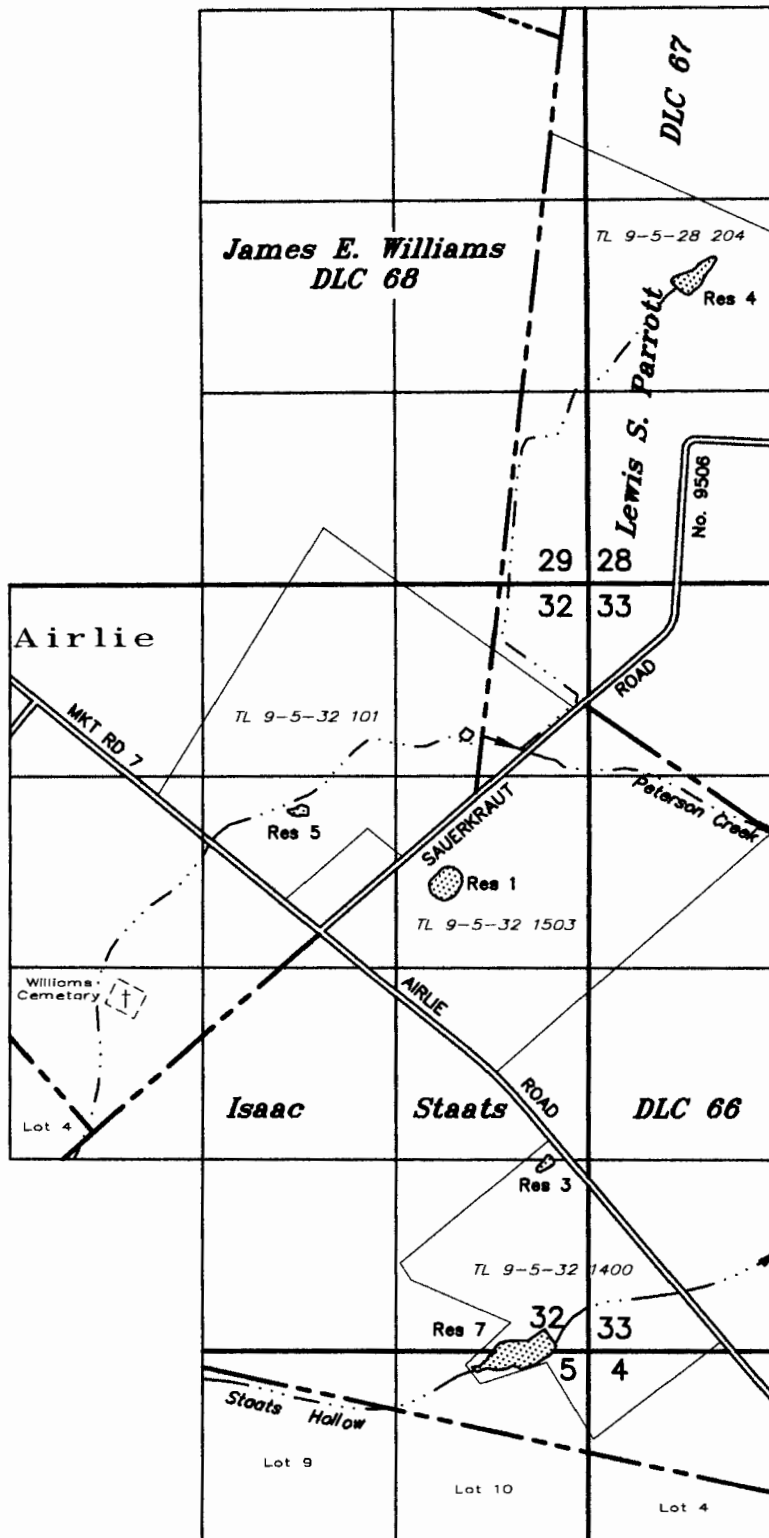

POD's

RES 1:
1145' S & 855' W
N'y COR STAATS DLC 66

RES 3:
1320' N & 240' W
SE COR SEC 32

RES 4:
2860' N & 660' E
N'y COR STAATS DLC 66

RES 5:
735' S & 1880' W
N'y COR STAATS DLC 66

RES 7:
90' N & 255' W
SE COR SEC 32

CERTIFICATES DO NOT
LIST POD'S, ONLY
RESERVOIR LOCATIONS

APPLICATION TO TRANSFER WATER RIGHT

CHARACTER OF USE

IN THE NAME OF

RECEIVED Hamilton Farms, LLC

AUG 31 2015

WATER RESOURCES DEPT
SALEM, OREGON

Certificate No. 41746
41747
81452 Transfer No. T-

August 8, 2015

SCALE: 1" = 1320'



NOTE: This map is not intended to
provide legal dimensions or locations
of property ownership lines.

T 12149

EXPIRES 12-31-15



Google earth



RECEIVED

AUG 31 2015

WATER RESOURCES DEPT
SALEM, OREGON

Date of Photograph: 7-14-2014

T 12149



Google earth

feet
meters



T 12149

RECEIVED

AUG 31 2015

Date of Photograph 7-14-2014

WATER RESOURCES DEPT
SALEM, OREGON



Google earth

feet
meters



Date of Photograph: 7-14-2014

T 12149

RECEIVED

AUG 31 2015

WATER RESOURCES DEPT
SALEM, OREGON