


T21S, R29E, W.M.
Harney County, Oregon

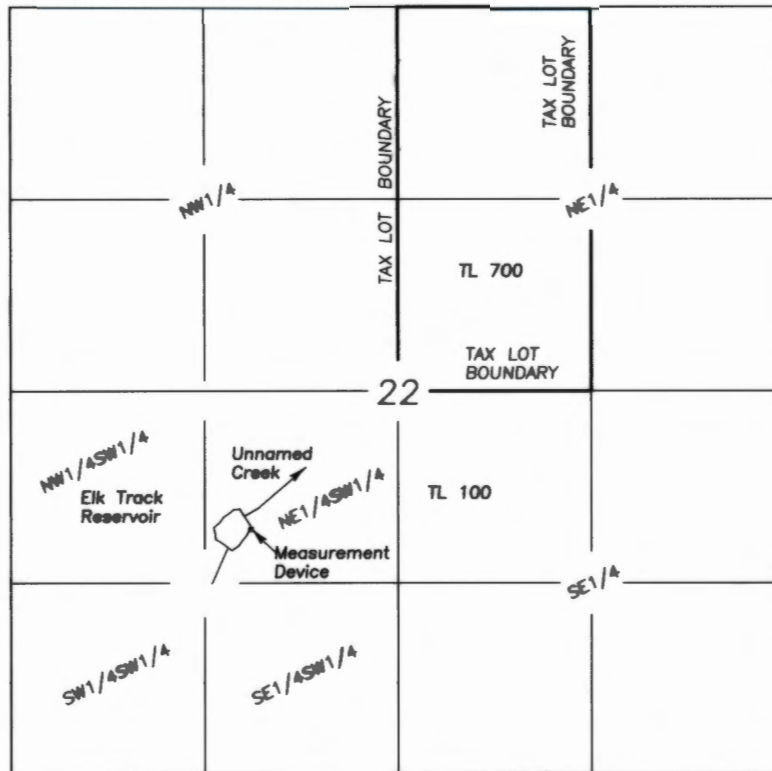

SCALE 1"=1320'

RECEIVED BY OWRD

AUG 29 2016

SALEM, OR

Outlet is located 1650' North & 1600' East of the
SW corner of Section 22.

Measuring device is located 4' North of the Outlet

FINAL PROOF SURVEY
CLAIM OF BENEFICIAL USE
ELK TRACK RESERVOIR

For

Bureau of Land Management

August 9, 2016

LEGEND

Application No. R-39361
Permit No. R-4397
Priority 1/6/1964

A portion of Tax Lot
21-29 TL100

NOTE: Tax Lot 100 is owned by the BLM
and is more that 19,000 acres.
Therefore only a portion of the tax
lot boundary can be shown.

Prepared by
Cornerstone Surveying, Inc

P.O. BOX 33
JOHN DAY, OR. 97845
(541)575-1813

cornerstonesurvey@centurytel.net

NOTE: The preparation of this map
was for the purpose of identifying
the location of the proposed water
right and has no intent to provide
dimensions or location of property
ownership lines.

