


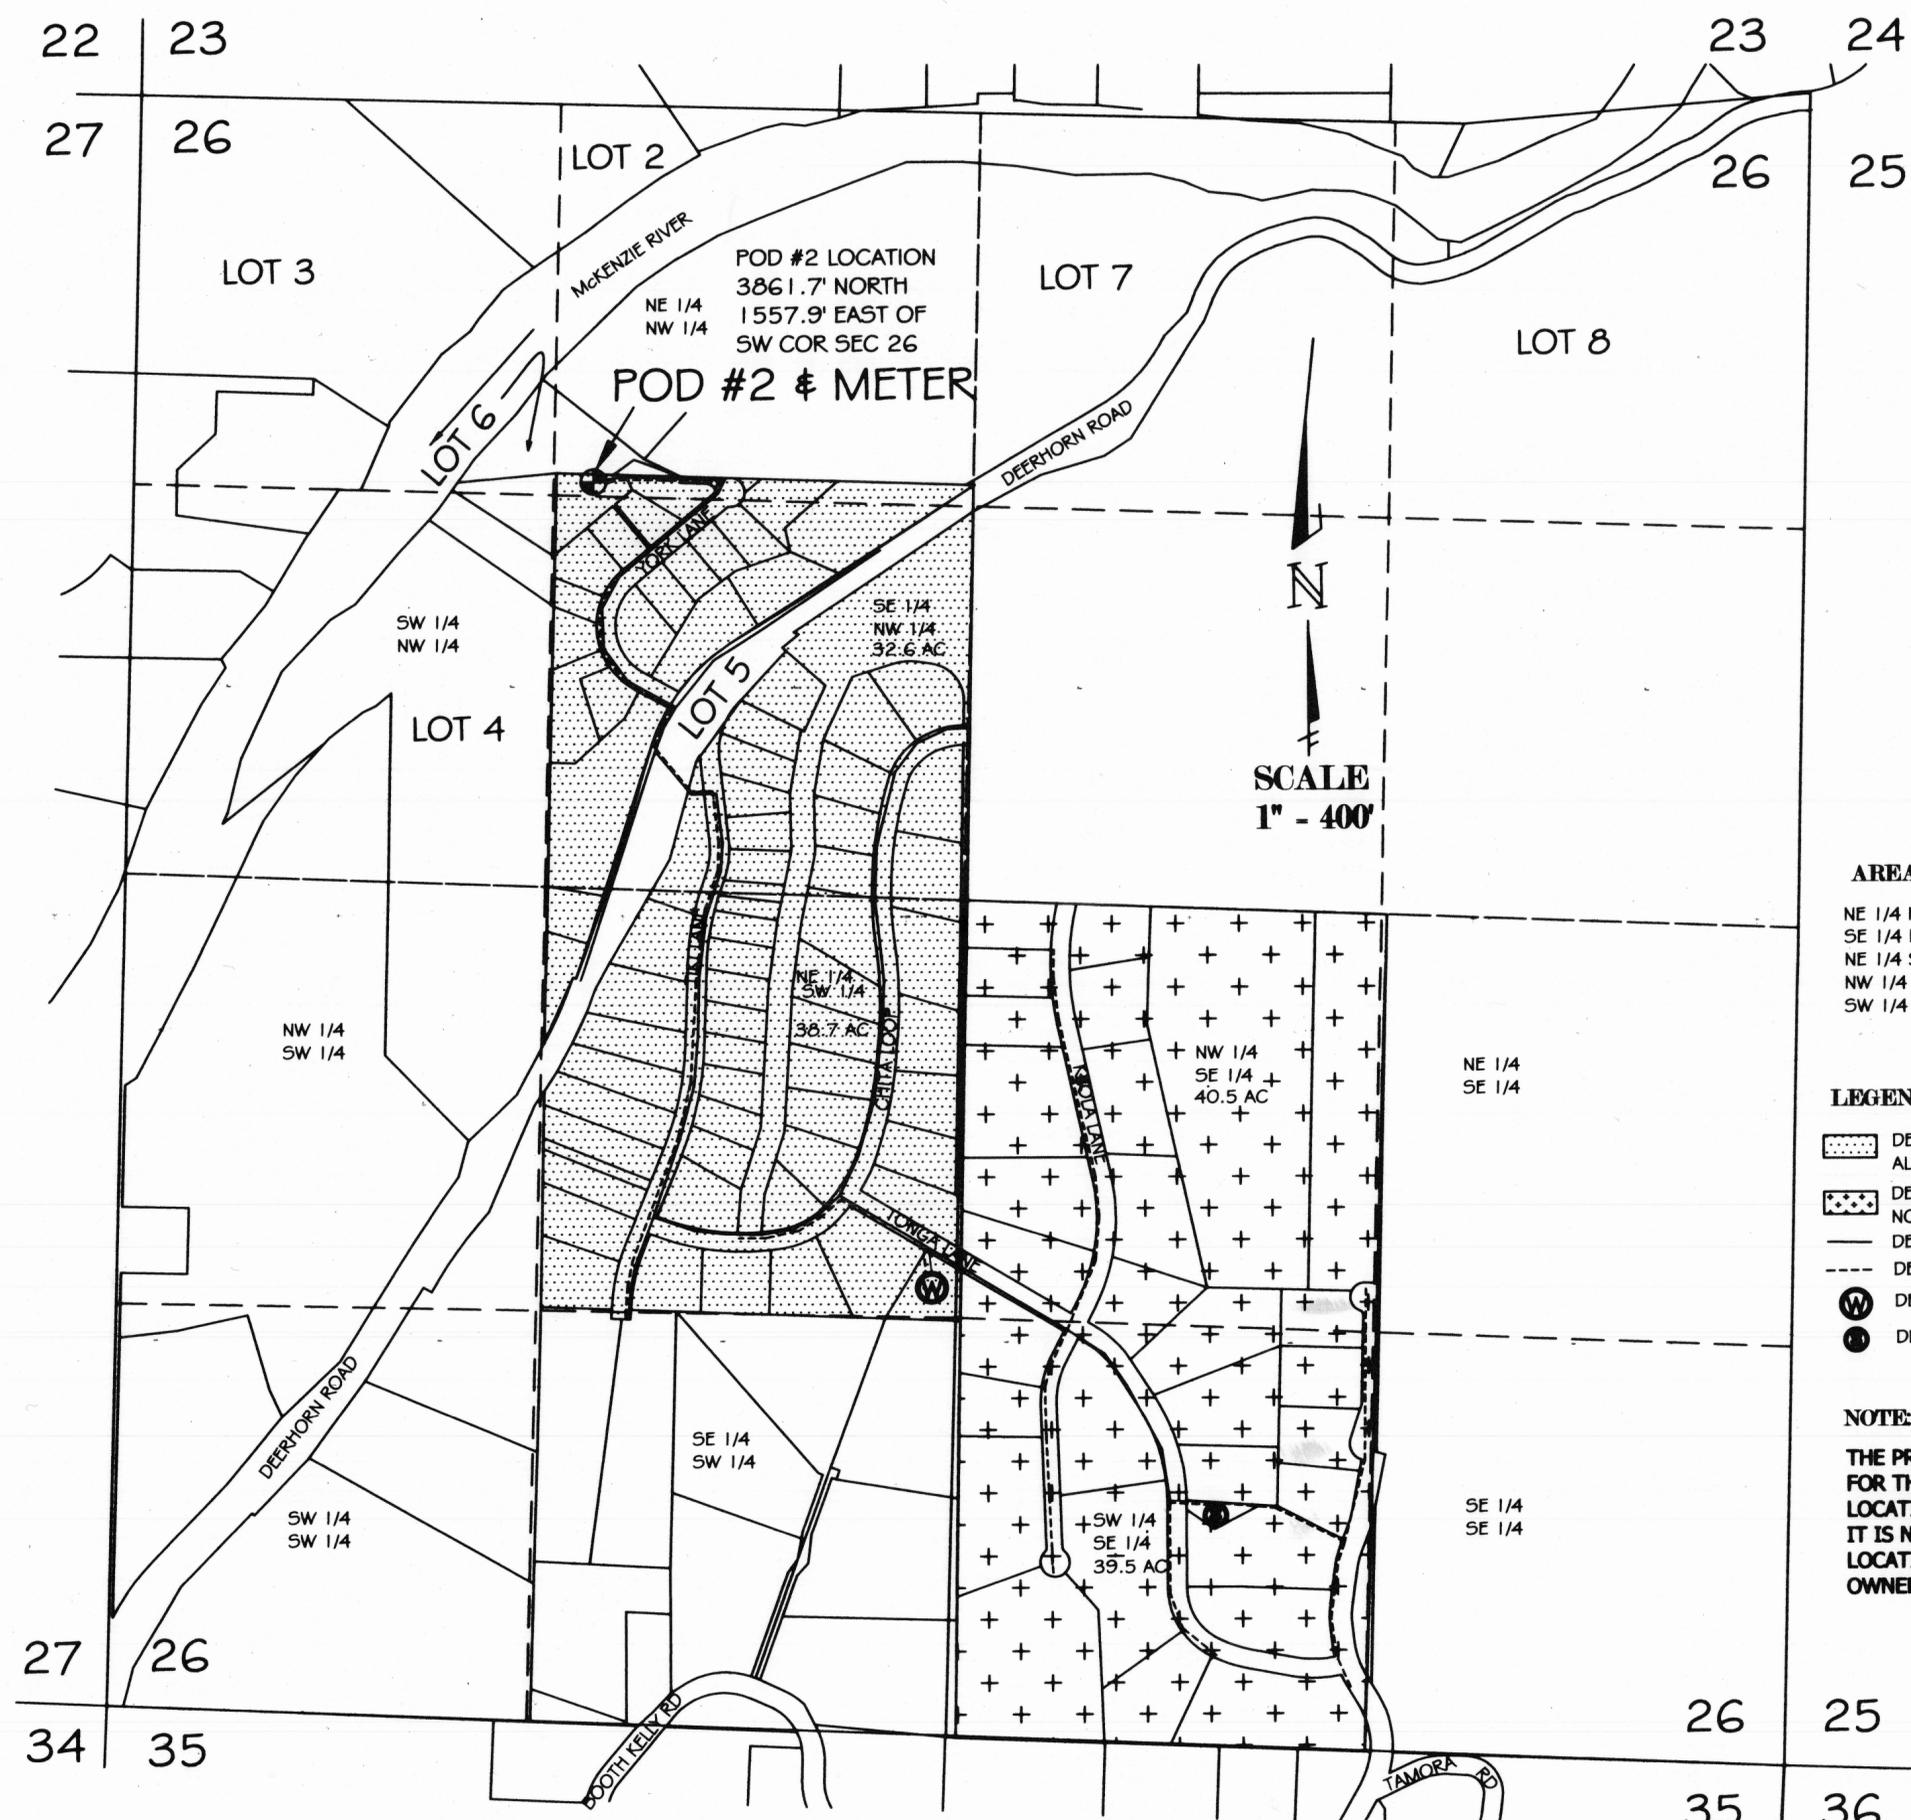

**FINAL PROOF SURVEY MAP  
FOR  
SHANGRI-LA WATER DISTRICT  
PERMIT # G-5533  
SEC. 26 IN T17S, R1W, W.M.  
PO BOX 67  
WALTERVILLE, OR 97146  
MARCH 29, 2016**

**H. TIMOTHY FASSBENDER, PLS, CWRE**  
  
2896 SARAH LANE  
Eugene, OR 97408  
  
(541) 485-3136  
541-913-0216

JOB NO. SHANGRI-LA  
DWG. NO. FINAL  
BY: HTF



**SCALE**  
1" = 400'

RECEIVED BY OWRD  
OCT 03 2016  
SALEM, OR

**APPLICATION G-5737**