
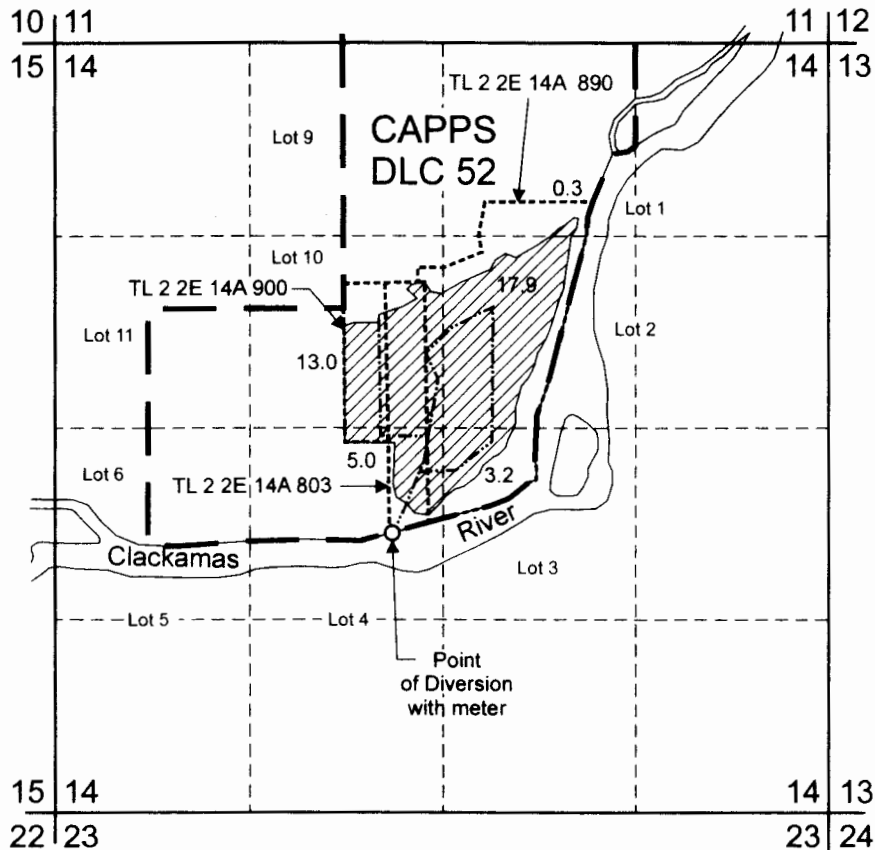



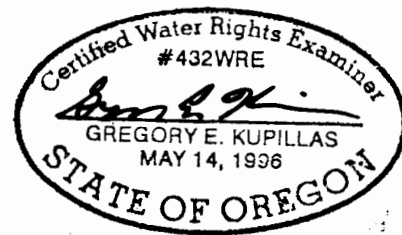


T.2S. R.2E. Section 14, W.M.

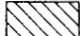


Point of diversion is located 1,540 feet south and 330 feet east from the re-entrant corner, Capps DLC 52.

-  Area (39.4 Acres) irrigated under T-10468
-  Tax lot boundary
-  Donation Land Claim boundary
-  Irrigation mainline, buried



EXPIRATION DATE: 6/30/2013

Scale: 1" = 1,320'

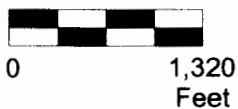

This map was prepared for the purpose of identifying the location of a water right only and is not intended to provide legal dimensions or location of property ownership lines.



**Claim of Beneficial Use Map
T-10468**

Sah-Hah-Lee Golf Course
T.2S. R.2E. Section 14, W.M.

Pacific Hydro-Geology Inc.

11/2011