


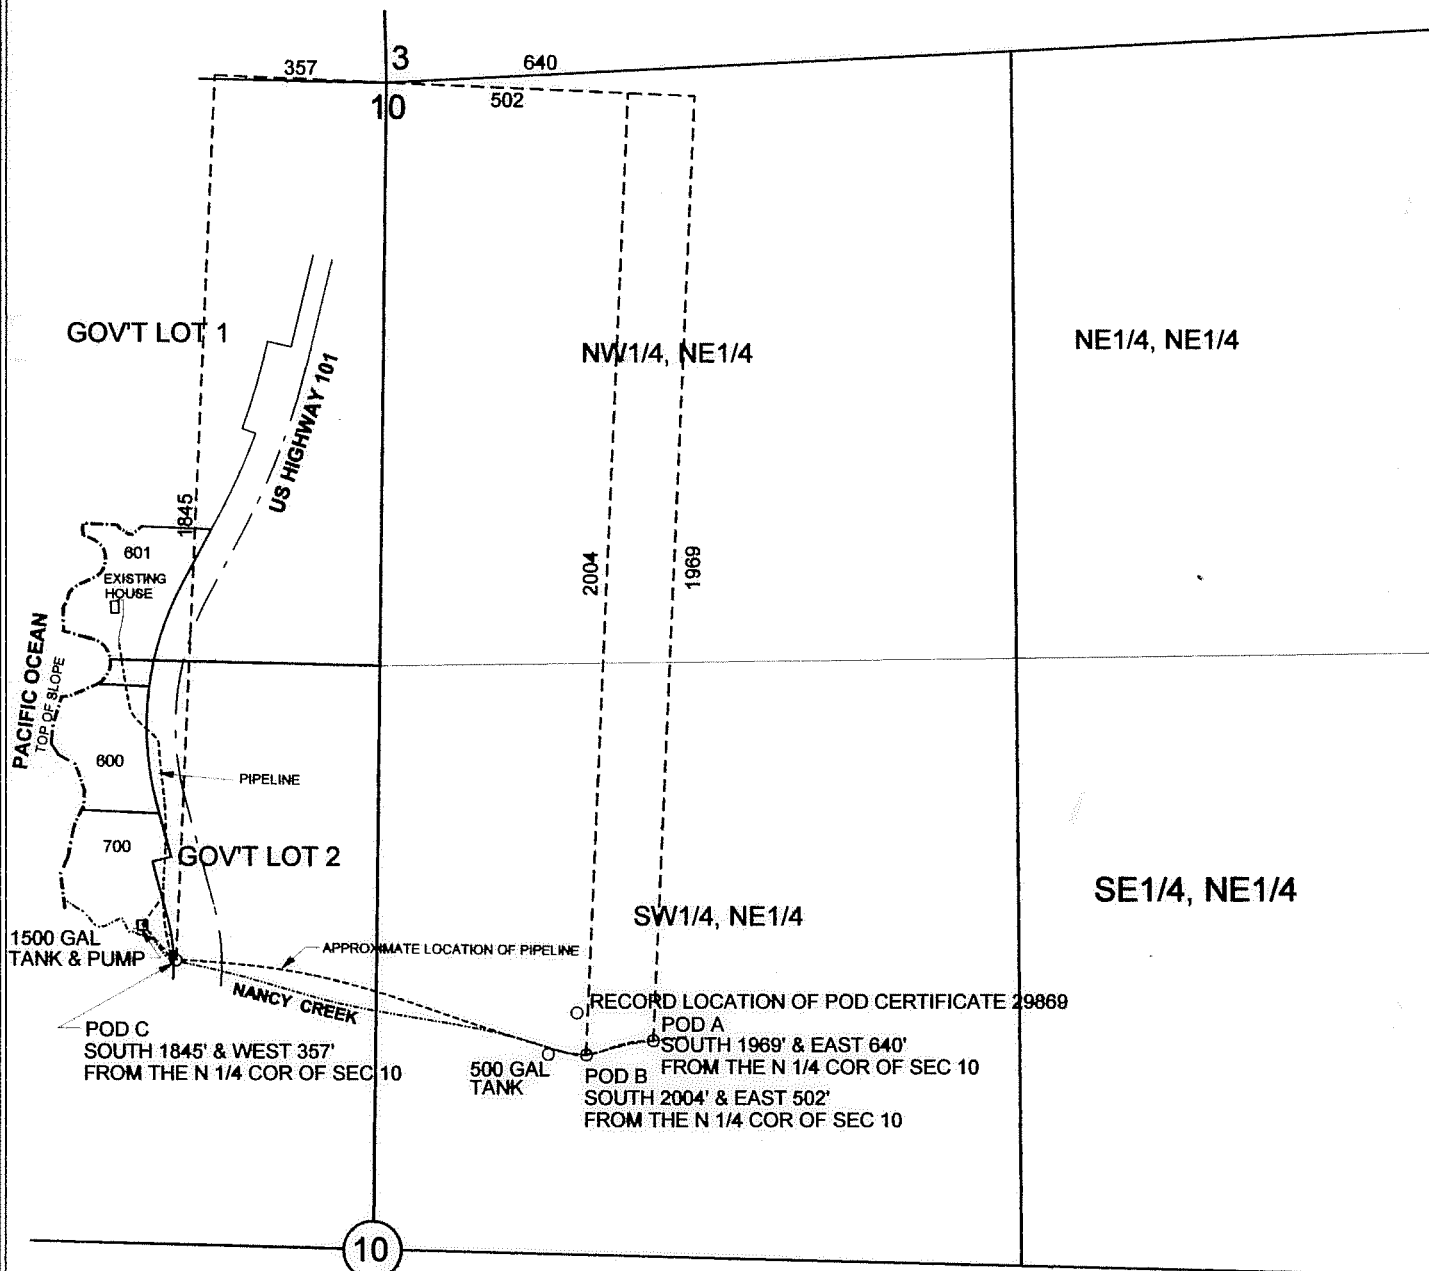

THIS MAP IS FOR THE PURPOSE
OF IDENTIFYING THE LOCATION
OF THE WATER RIGHT ONLY.
THERE IS NO INTENT TO PROVIDE
DIMENSIONS OR LOCATION OF
PROPERTY OWNERSHIP LINES.

CLAIM OF BENEFICIAL USE WATER RIGHTS MAP MID COAST BASIN

TRANSFER
UNDER
APPLICATION T-10721

RECEIVED BY OWRD

JUL 17 2015

SALEM, OR

GOV'T LOT 1, SEC 10, T16S, R12W, W.M.
GOV'T LOT 2, SEC 10, T16S, R12W, W.M.
SW 1/4, SE 1/4, SEC 10, T16S, R12W, W.M.

TAX MAP 16-12-10 T.L. 601
LANE COUNTY, OREGON

FOR: RUSSELL AND KRISTINE FOWLER
94200 HWY 101 S
YACHATS, OREGON 97498

PREPARED BY: WOBBE & ASSOCIATES, INC.
510 KINGWOOD ST. / P.O. BOX 3093
FLORENCE, OR 97439
DATE: JULY 7, 2015

