


EXHIBIT B

T18S, R35E, W.M.
Harney County, Oregon

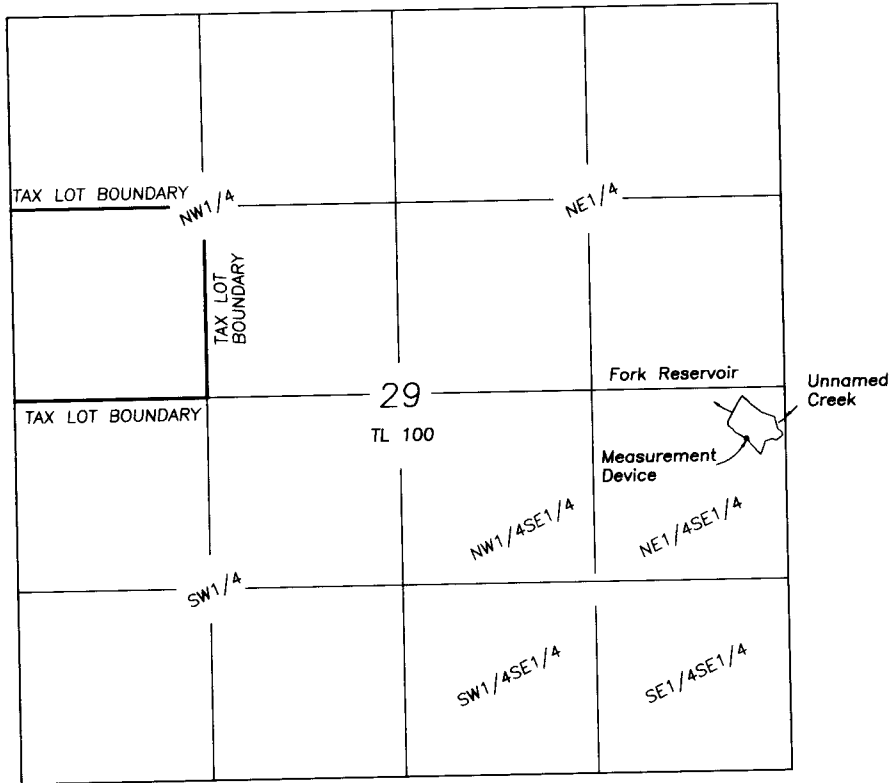

SCALE 1"=1320'

Outlet is located 2990' South & 280' West of the
NE corner of Section 29.

Measuring device is located 10' West of the Outlet

FINAL PROOF SURVEY
CLAIM OF BENEFICIAL USE
FORK RESERVOIR

For

Bureau of Land Management

August 3, 2016

LEGEND

Application No. R-48766
Permit No. R-7905
Priority 10/8/1971

A portion of Tax Lot
18-35 TL100

NOTE: Tax Lot 100 is owned by the BLM
and is more that 19,000 acres.
Therefore only a small portion of the tax
lot boundary can be shown.

Prepared by

Cornerstone Surveying, Inc

P.O. BOX 33

JOHN DAY, OR. 97845

(541)575-1813

cornerstonesurvey@centurytel.net

RECEIVED BY OWRD

AUG 29 2016

SALEM, OR

NOTE: The preparation of this map
was for the purpose of identifying
the location of the proposed water
right and has no intent to provide
dimensions or location of property
ownership lines.

