


MAP OF
WATER PERMIT SURVEY
 IN SEC. 16 T.29S. R.12W. WILMER.
 FOR
A. FURMAN

SCALE 1" = 500'

E. L. VINTON

DECEMBER-1925

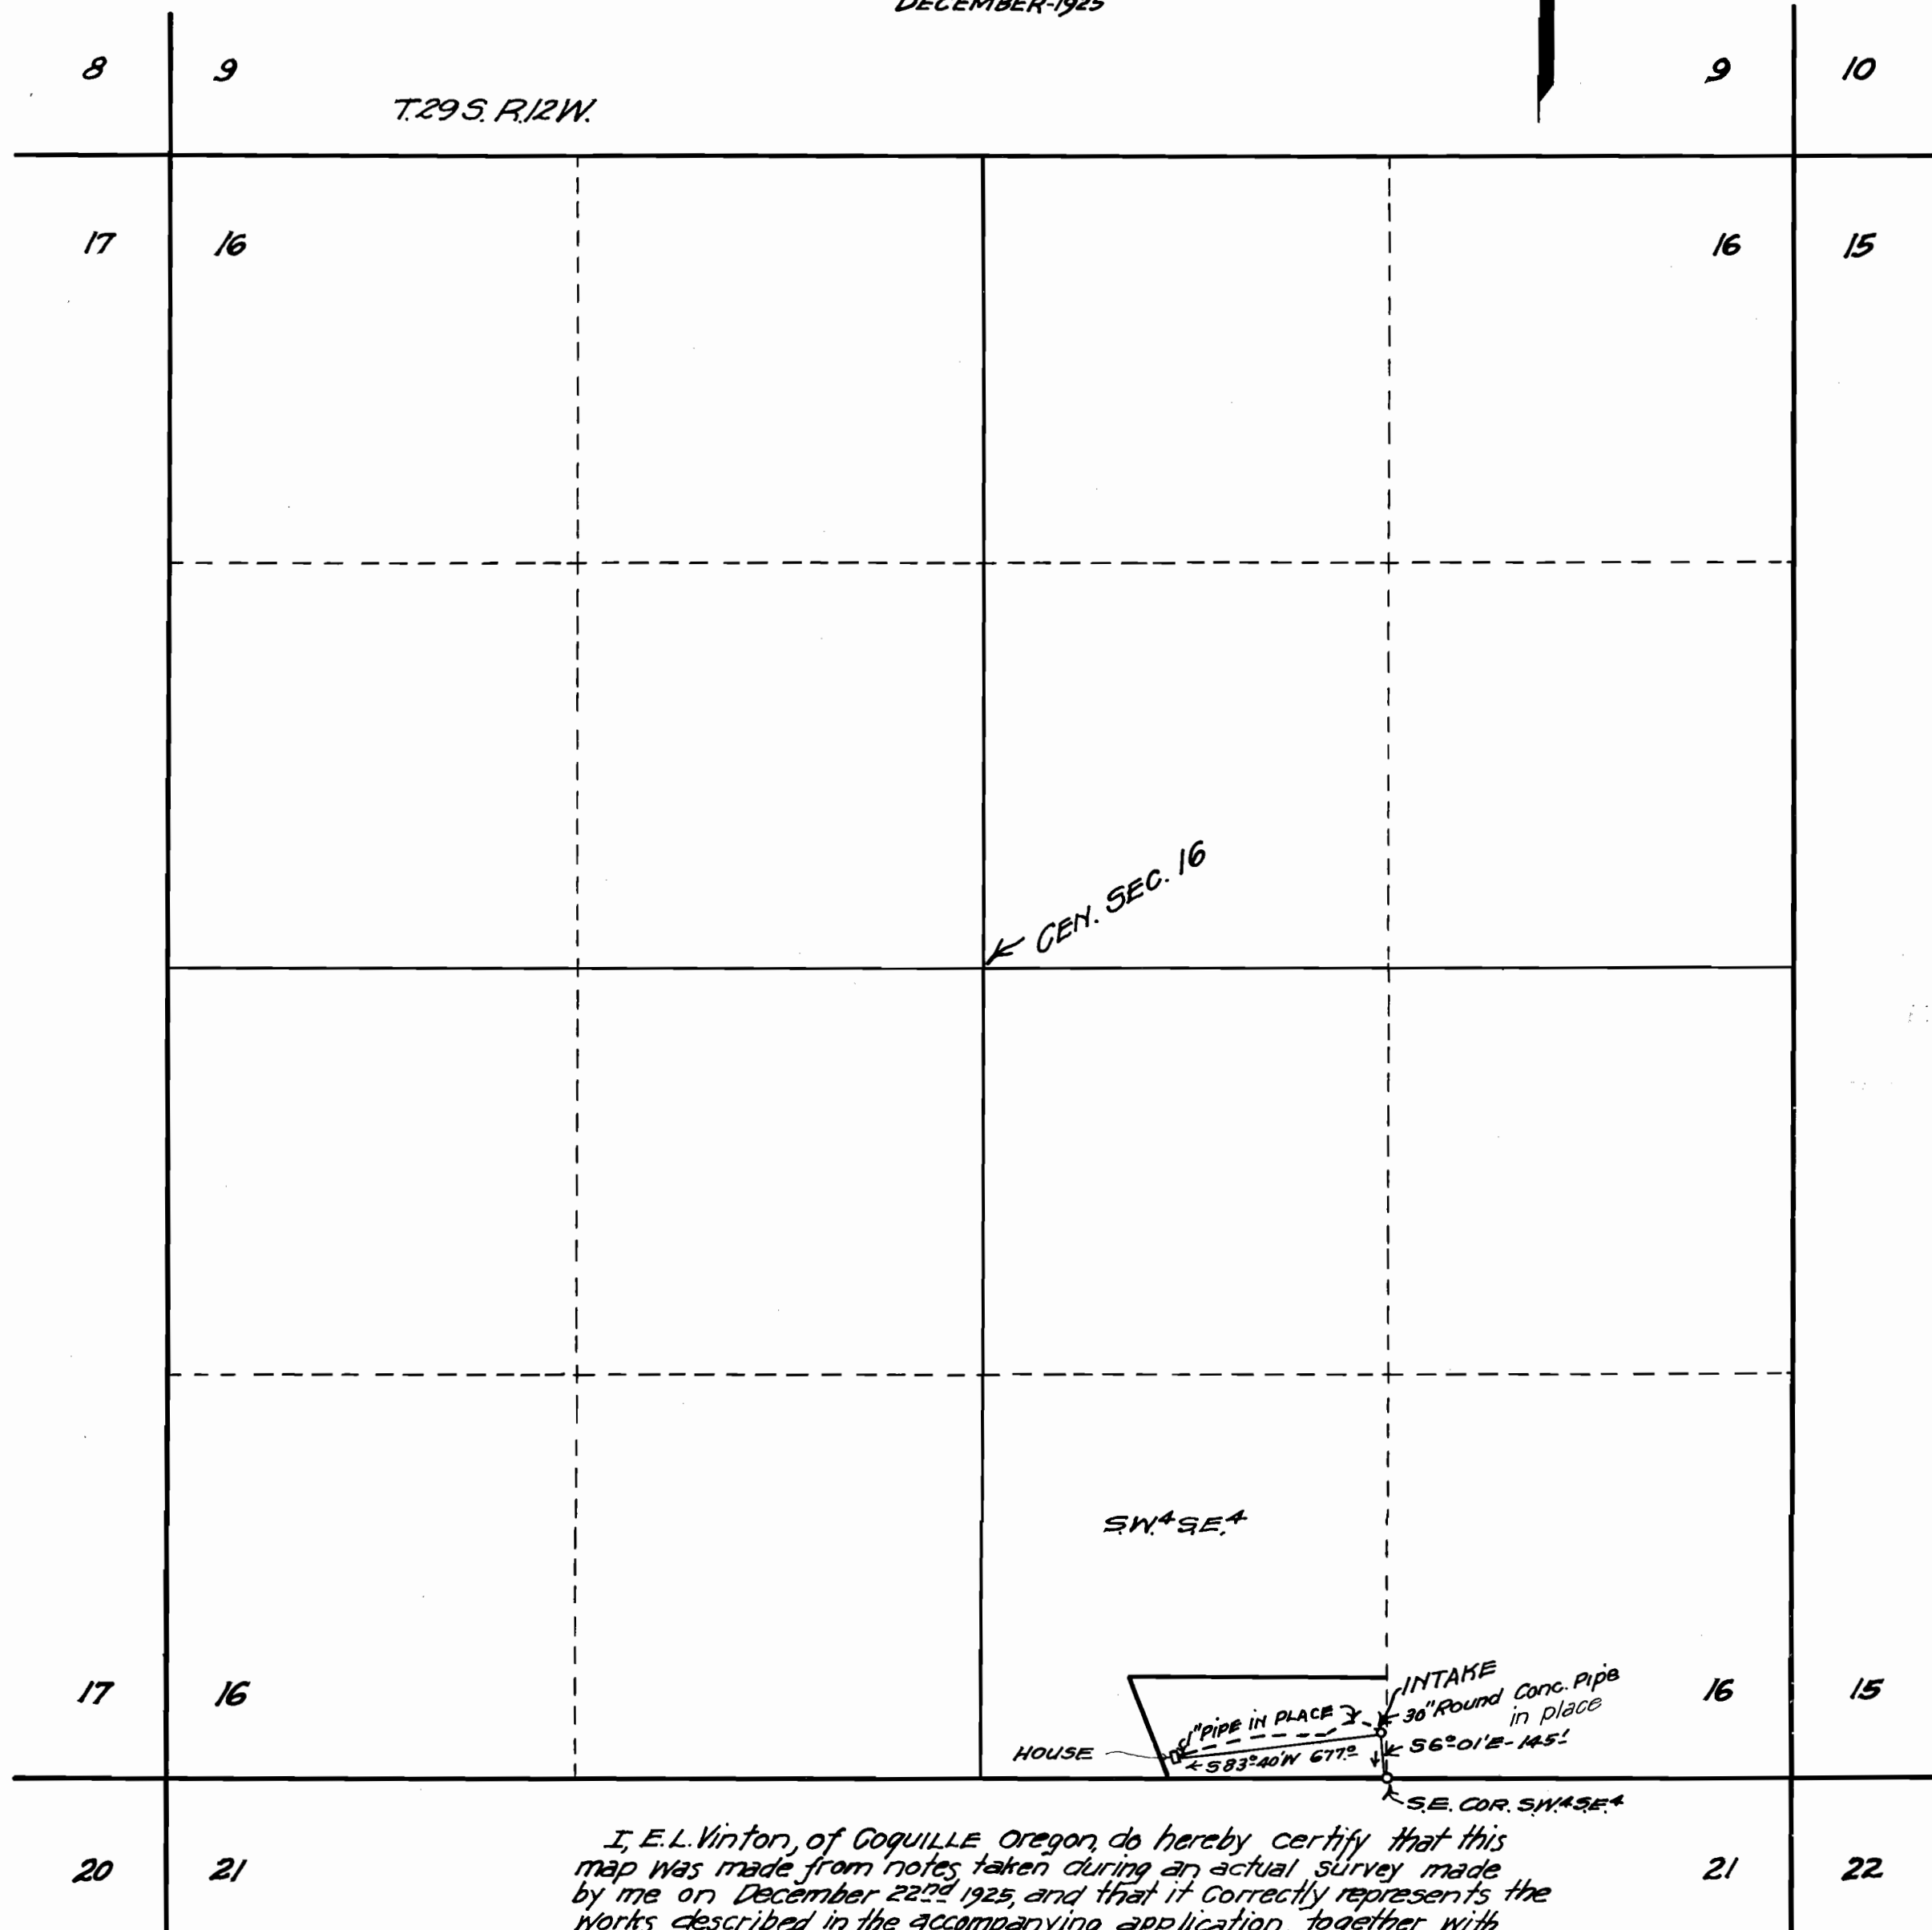

I, E. L. Vinton, of Coquille Oregon, do hereby certify that this map was made from notes taken during an actual survey made by me on December 22nd 1925, and that it correctly represents the works described in the accompanying application, together with the location of streams and other ditches in the immediate vicinity.

Oregon No 164
 Date of registration - Nov. 8 1919

E. L. Vinton
 Registered Professional Engineer

Application No 10553
 Permit No 7126