


EXHIBIT B

T21S, R30E, W.M.
Harney County, Oregon

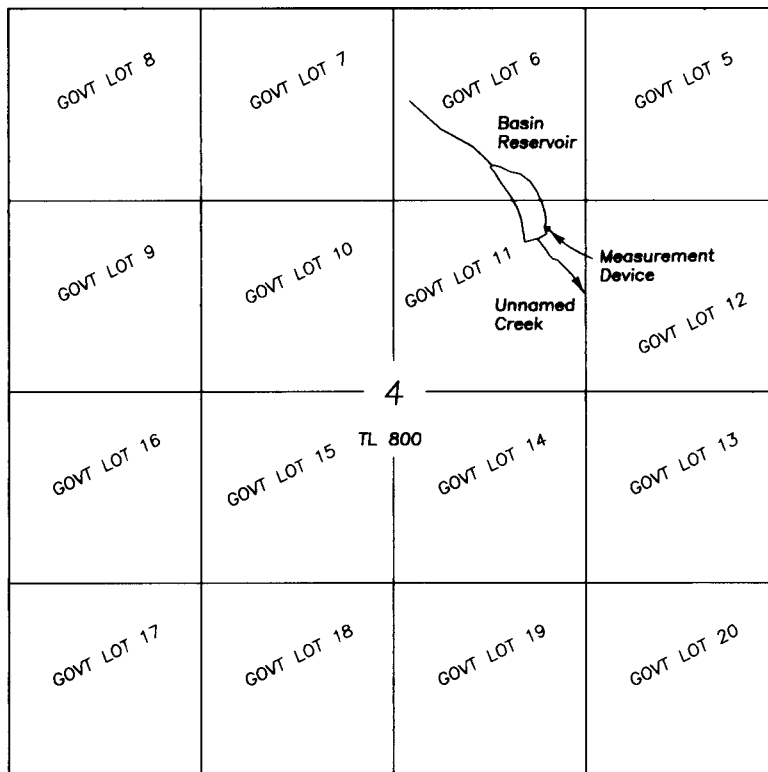

SCALE 1"=1320'

Outlet is located 1500' South & 1600' West of the
NE corner of Section 4.

Measuring device is located 27' North & 16' West of the Outlet

FINAL PROOF SURVEY
CLAIM OF BENEFICIAL USE
BASIN RESERVOIR

For

Bureau of Land Management

August 12, 2016

LEGEND

Application No. R-59641
Permit No. R-8076
Priority 12/21/1979

A portion of Tax Lot
21-30 TL 800

NOTE: Tax Lot 800 is owned by the BLM
and is more that 12000 acres.
No tax lot boundaries can be shown.

RECEIVED BY OWRD

AUG 29 2016

SALEM, OR

Prepared by
Cornerstone Surveying, Inc

P.O. BOX 33

JOHN DAY, OR. 97845

(541)575-1813

cornerstonesurvey@centurytel.net

NOTE: The preparation of this map
was for the purpose of identifying
the location of the proposed water
right and has no intent to provide
dimensions or location of property
ownership lines.

