





T.40S. R.19E. W.M.

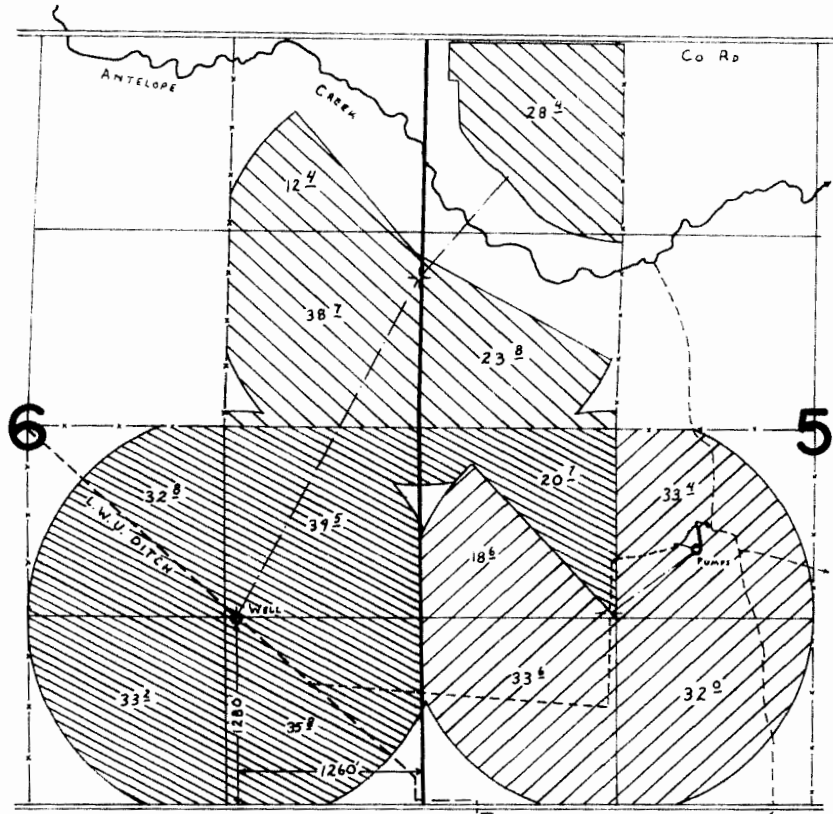

-  - PRIMARY IRR. fr. WELL (APP. G-7704)
-  - SUPPLEMENTAL IRR. fr. WELL (APP. G-7704)
-  - PRIMARY IRR. fr. WELL (APP. G-7461)

FINAL PROOF SURVEY UNDER

Application No. ~~G-7704~~ ^{G-7461} Permit No. ~~G-7160~~ ^{G-8059}
IN NAME OF

JACK ALBERTSON

Surveyed June 10, 1980, by C.L. Hughes

RECEIVED BY OWRD

JUL 11 2016

SALEM, OR