


T.7S. R.1E. Section 10, W.M.

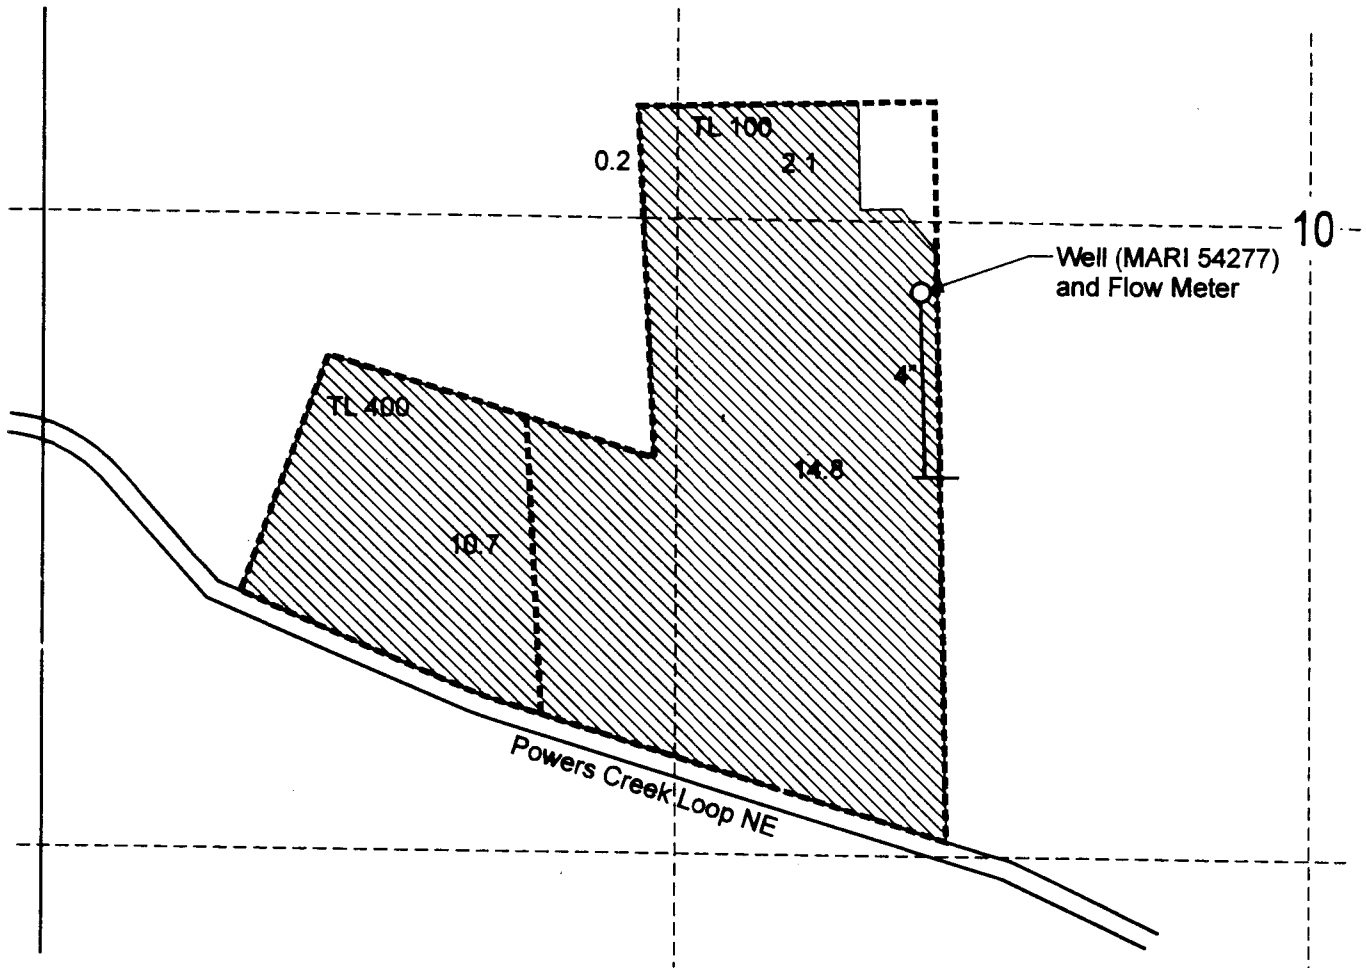

Well (MARI 54277) is located 140 feet south and 810 feet west from the C 1/4 corner, Section 10.



 Area (27.8 Acres) irrigated under Application G-15023, Permit G-13849.

----- Tax lot boundary

RECEIVED

WATER RESOURCES DEPT
SALEM, OREGON

Scale: 1" = 400'

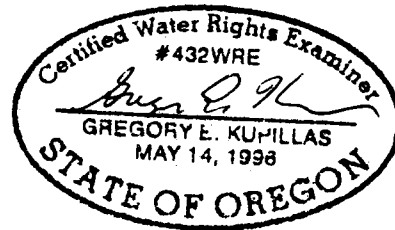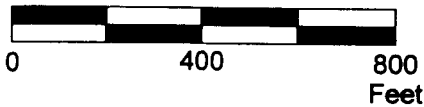

EXPIRATION DATE: 6/30/07

This map was prepared for the purpose of identifying the location of a water right only and is not intended to provide legal dimensions or location of property ownership lines.



Claim of Beneficial Use Map
Application G-15023, Permit G-13849

Pacific Hydro-Geology Inc.

Jan Hupp

10/2005

HuppOwnedCOB05.cdr