


# T. 3 S. R. 1 W. W.M.

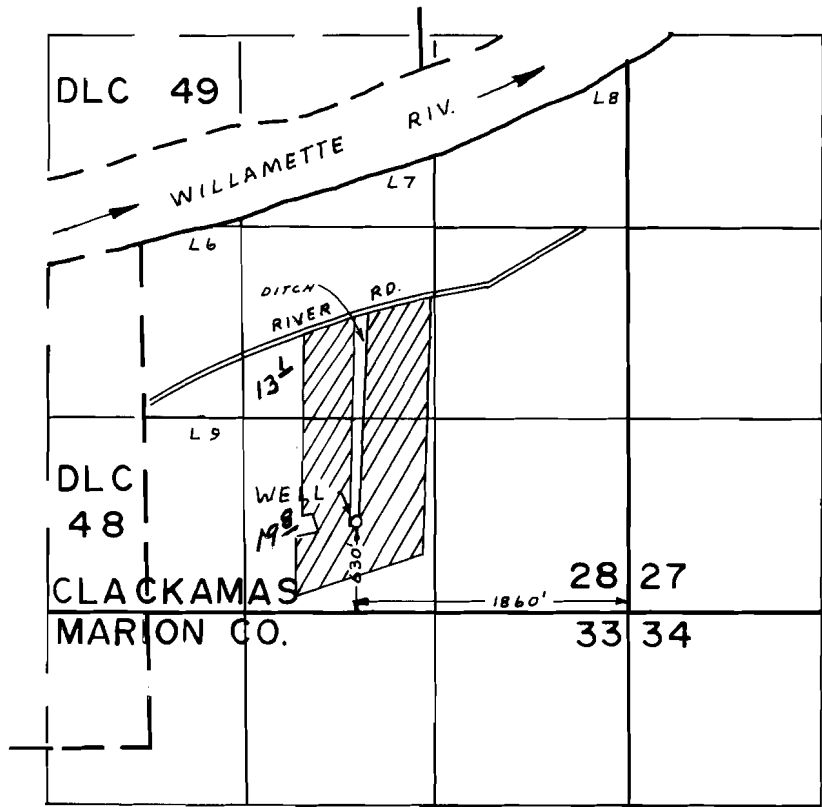

## FINAL PROOF SURVEY UNDER

Application No. G-4513 Permit No. G-4253  
IN NAME OF

NATHAN J. KURTH

Surveyed AUG. 15 1974, by L. H. NUNN