

T.20S., R16E., W.M. SECTIONS 5 AND 6


Located in NE 1/4 NW 1/4, SE 1/4 NW 1/4, NE 1/4 SW 1/4, and NW 1/4 SW 1/4 of
Section 5, TAX LOTS 20-16-00-1206, 1212, and 1213,
And in NE 1/4 NE 1/4, SE 1/4 NE 1/4, and NE 1/4 SE 1/4 OF Section 6,
TAX LOT 20-16-00-1204



SCALE: 1" = 1320'

LEGEND


— . . . — Property Line
- - - - - 1/16th Line
..... Tax Lot Line
— Section Line

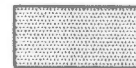

Place of Use


NE 1/4 SW 1/4 Section 5— 1.92 acres
NW 1/4 SW 1/4 Section 5— 1.58 acres
NE 1/4 SE 1/4 Section 6— 0.39 acres

Total = 3.89 Acres

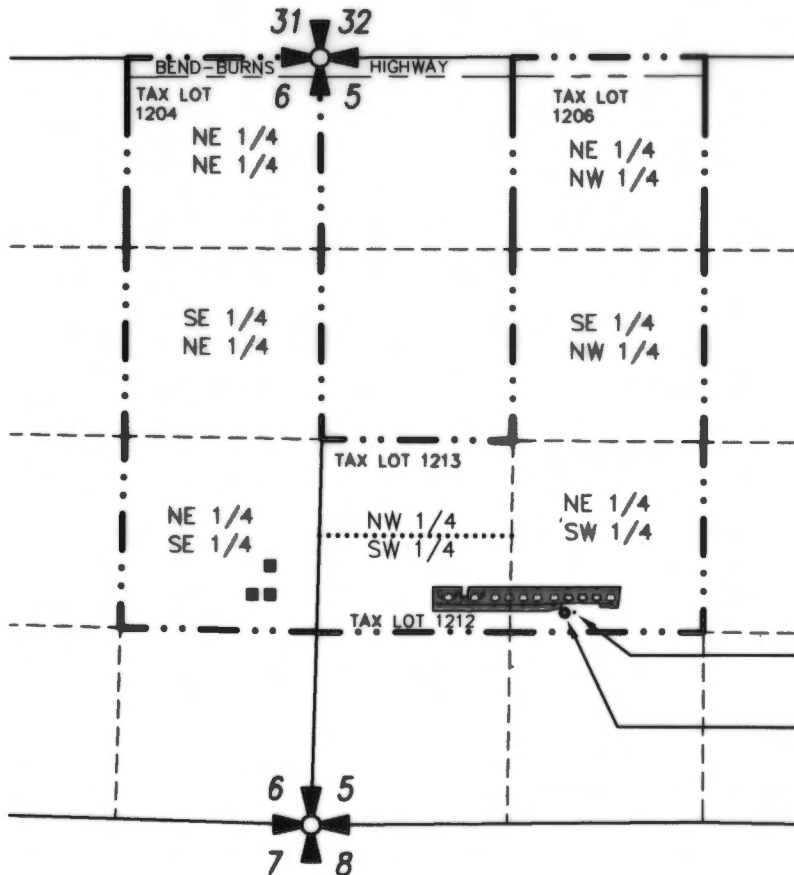

Meter, approximately 5 feet East of
POD

POD Well 3825 feet South, 1682 feet
East of Northwest Corner of Section
5, T 20 S, R 16 E

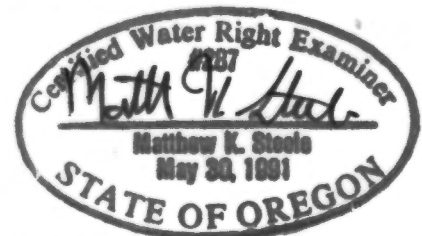

CLAIM OF BENEFICIAL USE MAP UNDER

Application No.G-16873 Permit No.G-16505 Amendment No.T-10973
IN NAME OF

BEND TRAP CLUB

Prepared: Date 2-24-2011 by Hickman Williams & Associates, Inc.
62930 O.B. Riley Road, Ste. 100, Bend, Oregon, 97701
Phone: 541-389-9351, Fax: 541-388-5416

RECEIVED

FEB 28 2011

WATER RESOURCES DEPT
SALEM, OREGON

This map is for the purpose of identifying the location of water right only and is
not intended to provide legal dimensions or locations of property ownership lines.