


TOWNSHIP 24 SOUTH, RANGE 33 EAST, W.M.

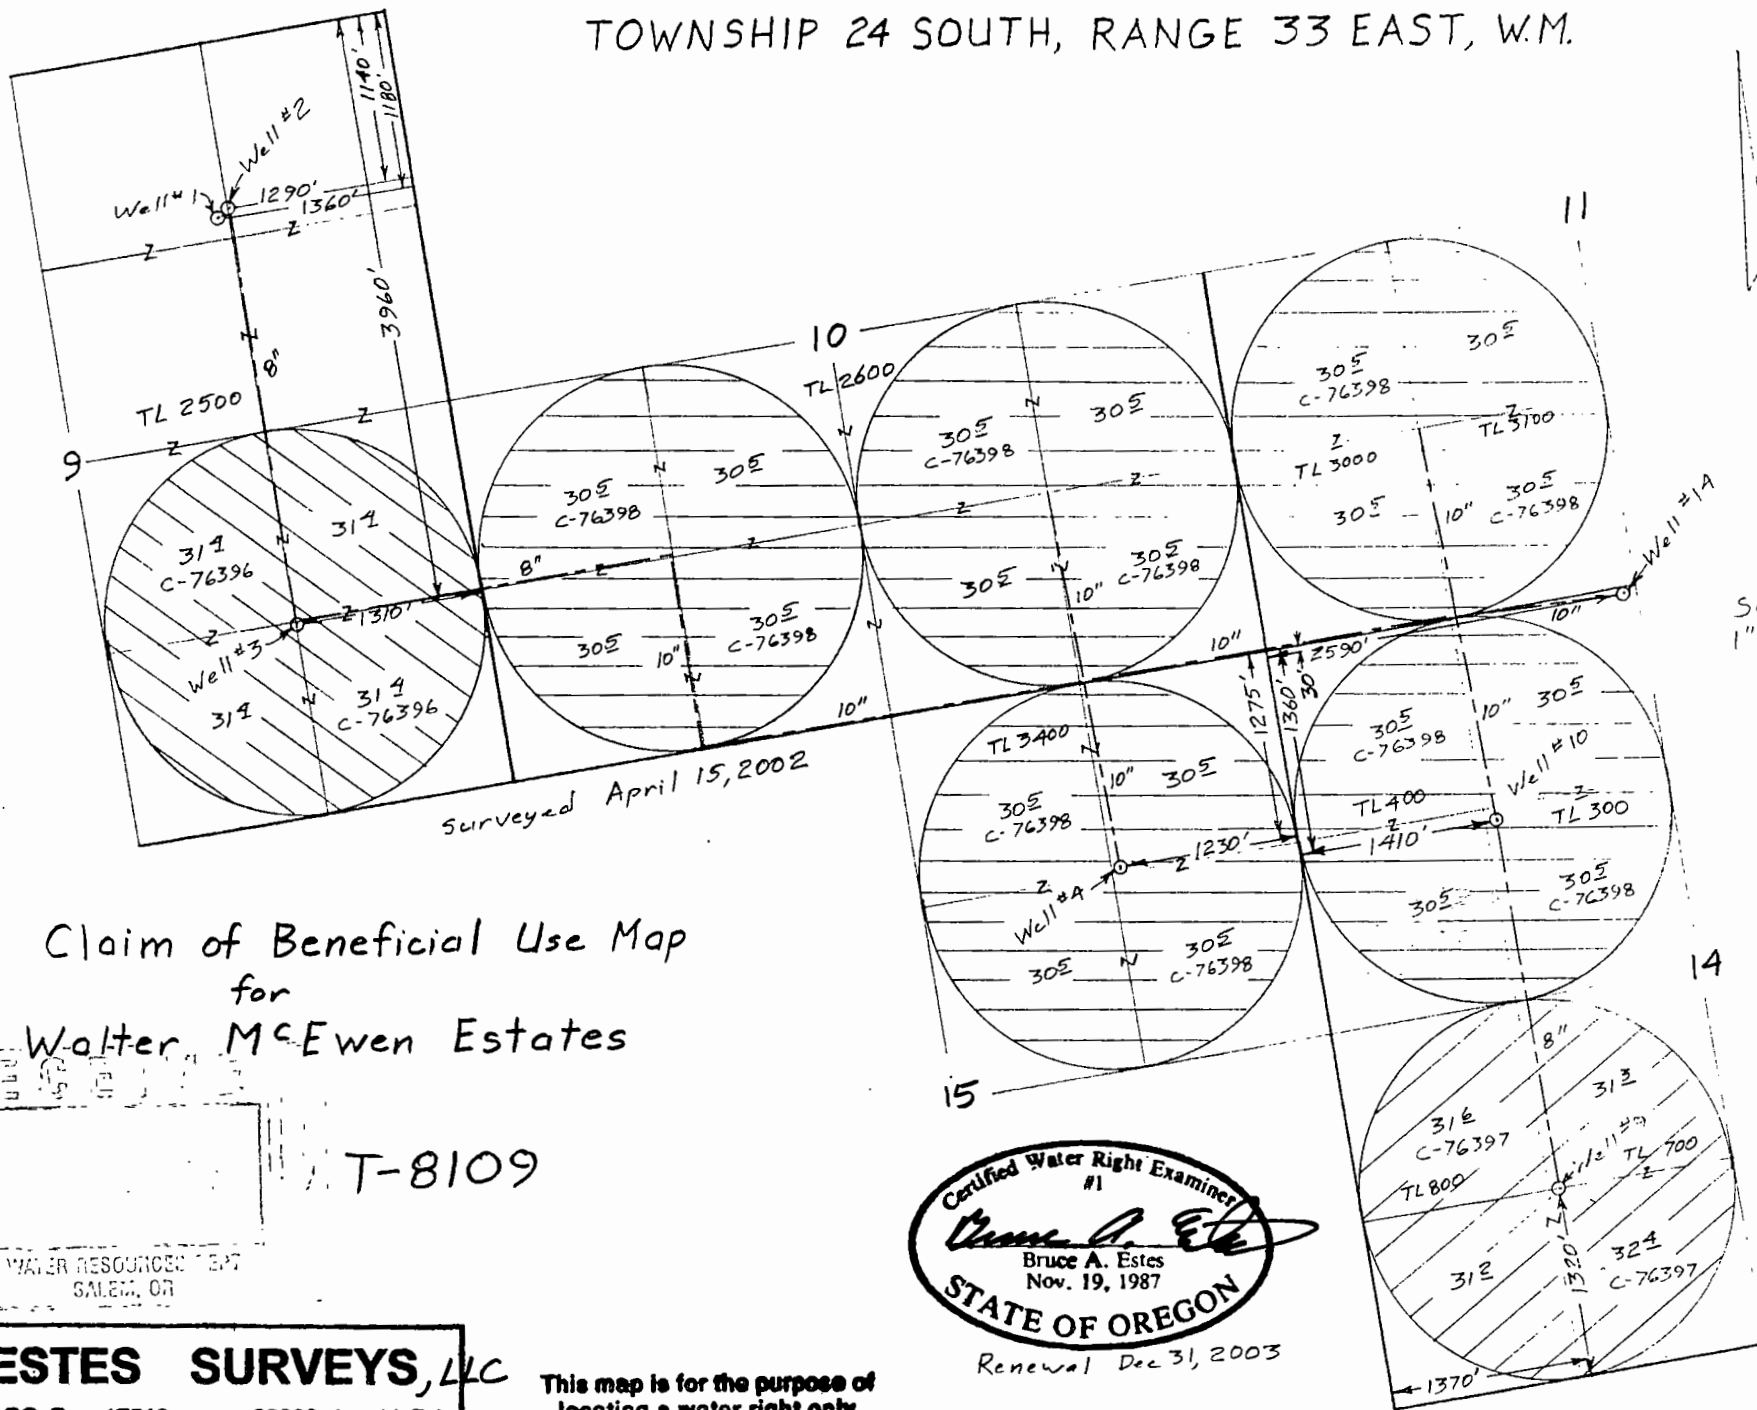

Scale
1" = 1320'

Surveyed April 15, 2002

Claim of Beneficial Use Map
for
Walter McEwen Estates

T-8109



ESTES SURVEYS, LLC
 PO Box 17519 60382 Arnold Rd
 Salem, OR 97305-7519 Bend, OR 97702
 (503) 585-7593 (541) 382-7391

This map is for the purpose of
locating a water right only
and has no intent to provide
legal dimensions or the location
of property lines.

WATER RESOURCES DEPT
SALEM, OR