


Application No. 10238  
Permit No. 7150

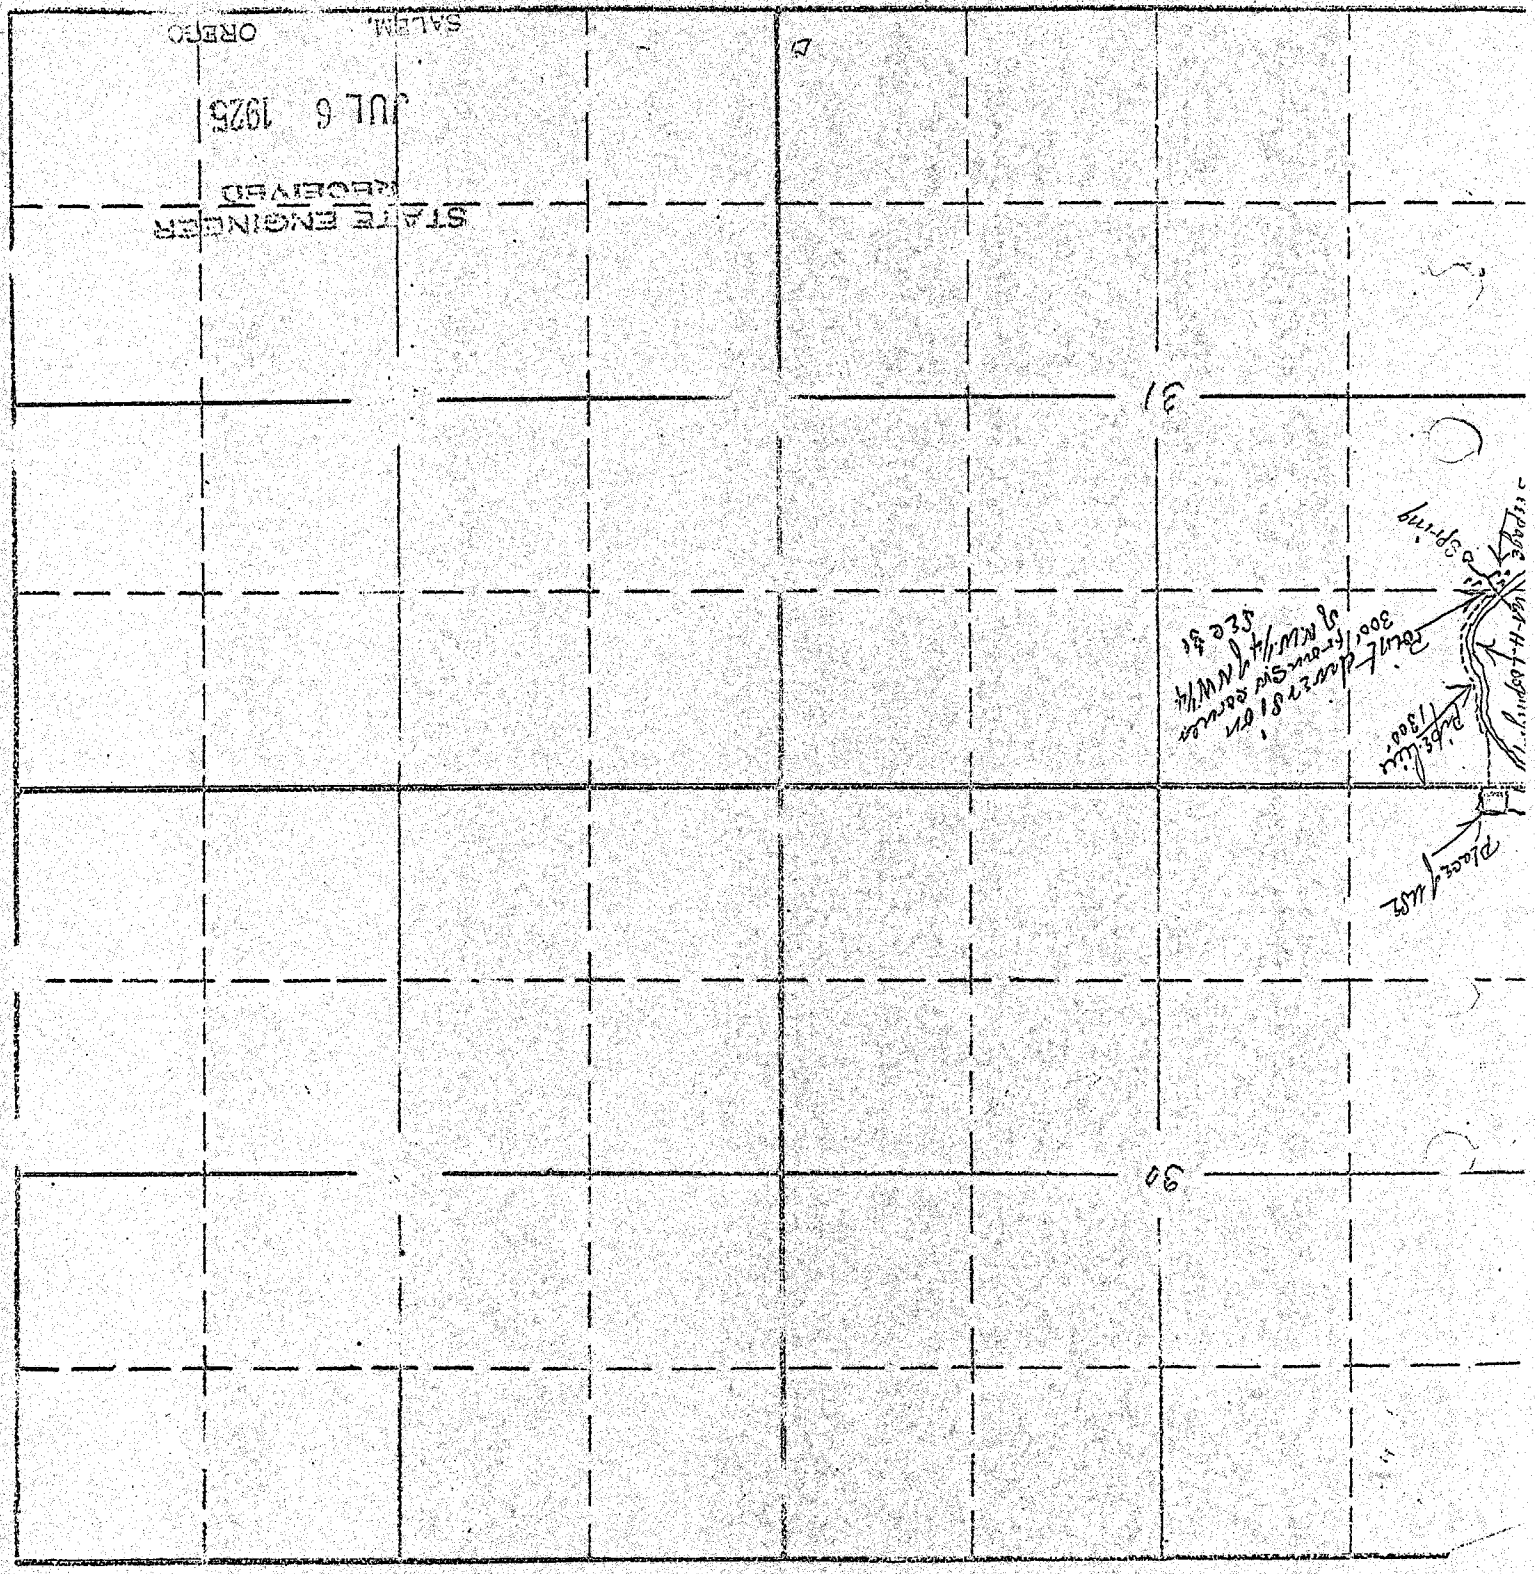

STATE ENGINEER  
RECORDED  
JUL 6 1926  
SALM. OREGON

7150

10 31  
R. L. S. W. H.  
11 31