

FINAL PROOF MAP


TO ADD A POINT OF APPROPRIATION
FOR TRANSFER T-9358
HARMONY LAKE RANCH

TOWNSHIP 27 SOUTH, RANGE 17 EAST, SECTION 33, W.M.
TAX LOTS: 600 & 601

REC-22

JAN 30 2015

SALEM, OR

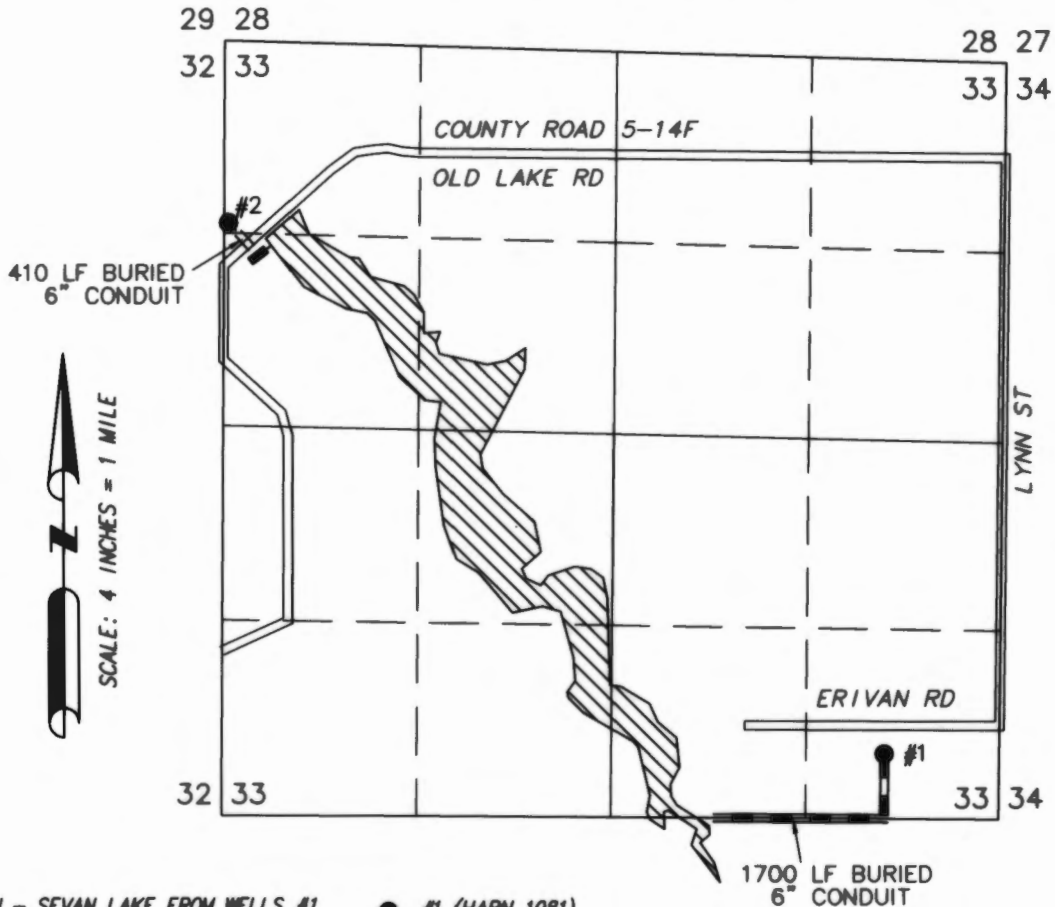


POA - SEVAN LAKE FROM WELLS #1
(G-5267) & #2 (T-9358), AS
SHOWN.

- #1 (HARN 1081)
AUTHORIZED POA
LOCATED IN THE SE 1/4 SE 1/4 SECTION 33, T27S R17E, W.M. AND
450 FEET NORTH AND 1680 FEET EAST FROM THE S 1/4 CORNER OF SAID
SECTION.
- #2 (HARN 4430)
TRANSFERRED POA
LOCATED IN THE NW 1/4 NW 1/4 SECTION 33, T27S R17E, W.M. AND
1252 FEET SOUTH AND 36 FEET EAST FROM THE NW CORNER OF SAID
SECTION.

FLOW METER IS LOCATED 6.75' WEST FROM WELL.

THIS MAP IS FOR THE PURPOSE OF LOCATING A WATER RIGHT ONLY AND HAS NO
INTENT TO PROVIDE LEGAL DIMENSIONS OR THE LOCATION OF PROPERTY LINES.

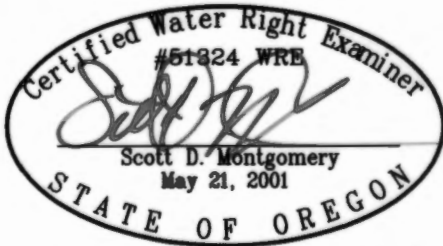

RENEWAL DATE: 12/31/2016

PREPARED FOR:

HARMONY LAKE RANCH
31884 NORTHWESTERN HWY
FARMINGTON HILLS, MI 48334

PREPARED BY:



ALL POINTS ENGINEERING AND SURVEYING, INC.
P.O. BOX 767 TERREBONNE, OR 97760
(541) 548-5833
www.APEandS.com