

NW1/4 SW1/4 SEC. 29 T16S. R.12E.W.M.

NE 1/4 SE 1/4
Section 30

W 1/4 corner Section 29

Service Boundary



Scale 1" = 200'

RECEIVED BY OWRD

SEP 30 2013

SALEM, OR


div. pt. located 520'S & 890'E from W 1/4 cor.

T-6821

Surveyed Aug 9, 2013

Claim of Beneficial Use Map
for

RIMROCK WATER IMPROVEMENT DIST.

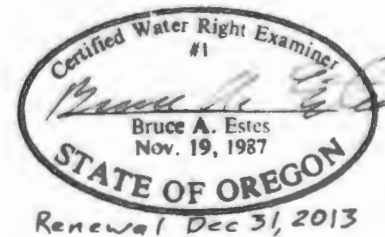

This map is for the purpose of locating a water right only and has no intent to provide legal dimensions or the location of property lines.

ESTES SURVEYS, LLC

PO Box 17540
Salem, OR 97303-7519
(503) 565-7505

60382 Arnold Rd
Bend, OR 97702
(541) 382-7391