



T.6S., R.2W., W.M.

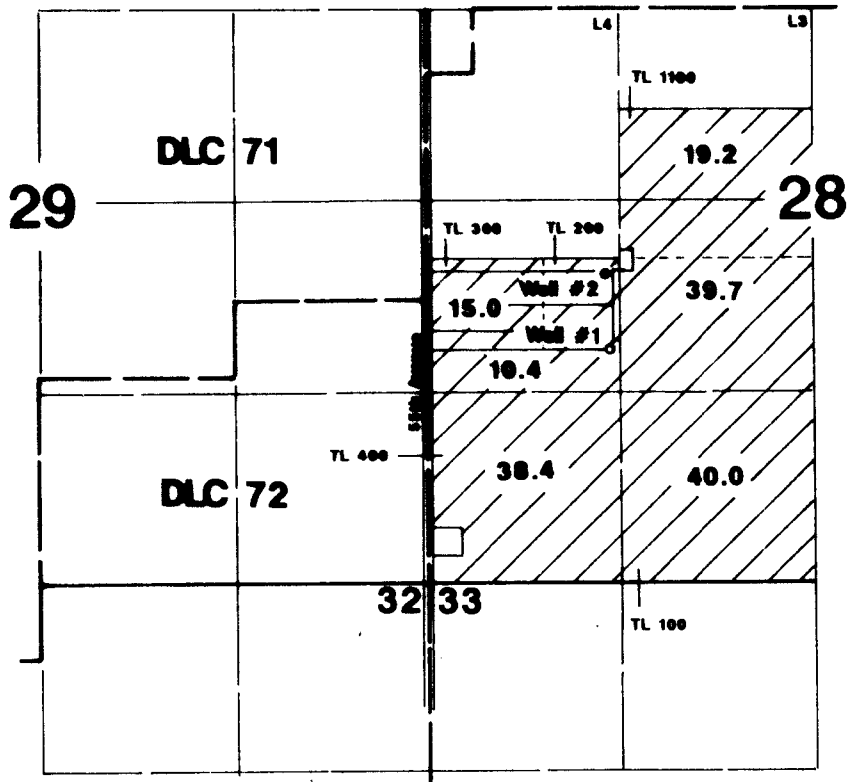

1" = 1320

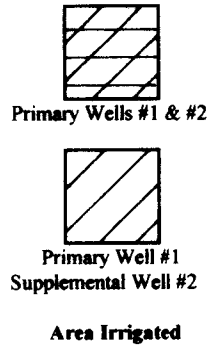

Well #1 is located 1650' N & 1250' E from the SW corner of Section 28.

Well #2 is located 2157' N & 1245' E from the SW corner of Section 28.

Final Proof Survey

In Name Of

Steve Erickson

Application #: G-14444 Permit #: G-13304

Surveyed on September 23, 2003 by JM Schuette

This Map Was Prepared For The Purpose Of Identifying The Location Of A Water Right Only And Is Not Intended To Provide Legal Dimensions Or Location Of Property Ownership Lines.

