
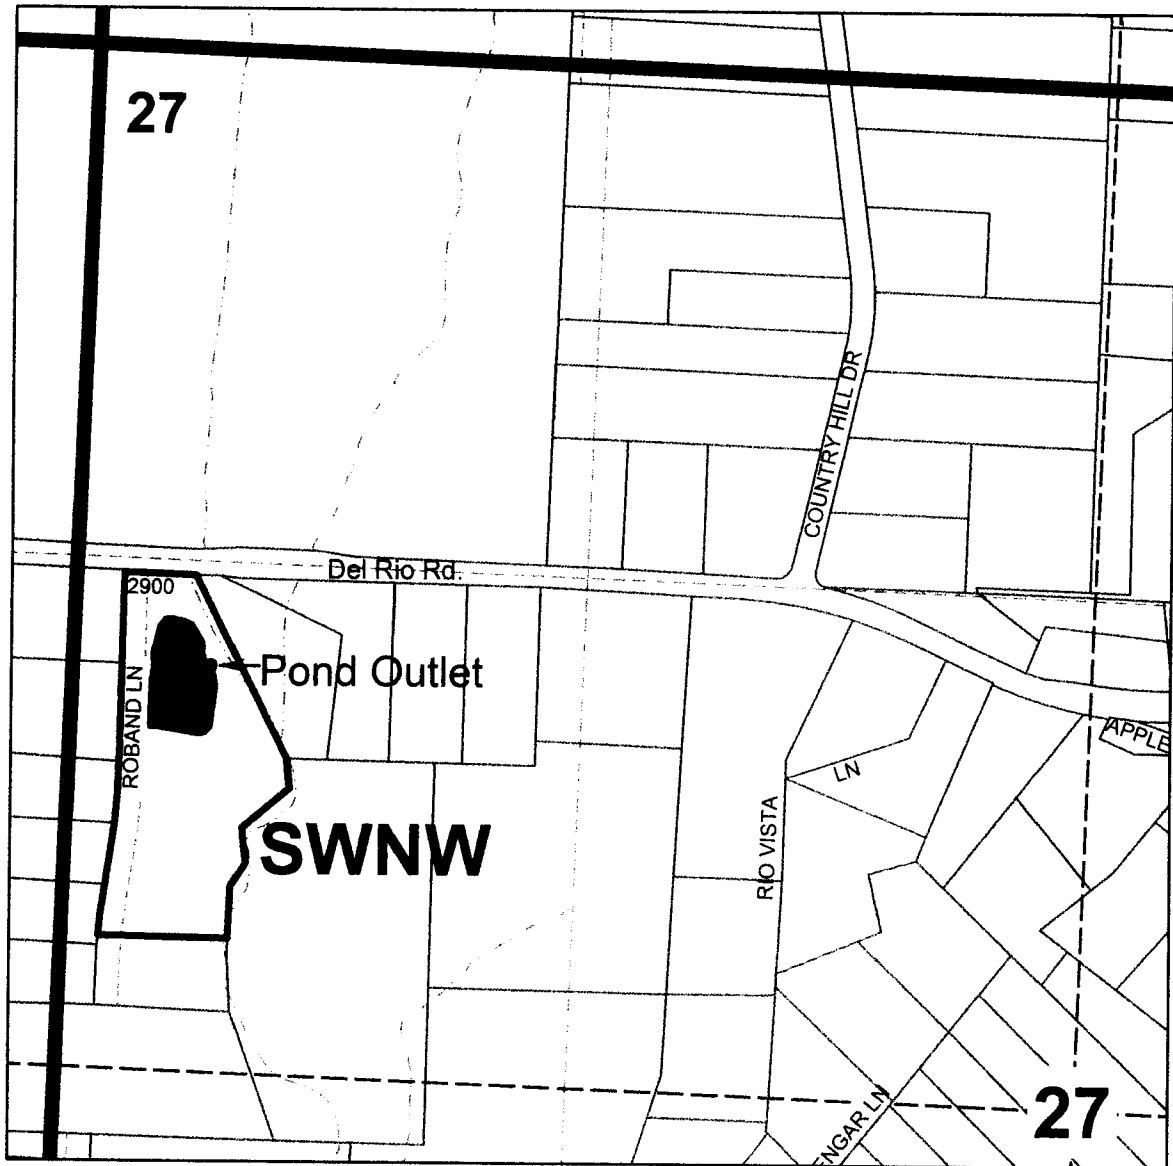


Final Proof Survey Map
Richard and Rebecca Mathews
NW 1/4 Section 27 T.26S. R.6W. W.M.
Douglas County
Scale: 1" = 500'

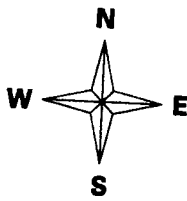

Pond Outlet is 1600' South and 360' East from the Northwest corner of Section 27.

RECEIVED BY OWRD

SEP 25 2015

SALEM, OR