

Map Updated by WRD to correctly identify the Quarter Quarters 4/3/16 DC

**LEGEND**

**LINE TYPES**

- TAX LOT BOUNDARY      OLD PROPERTY LINE
- ROAD RIGHT-OF-WAY      VACATED RIGHT-OF-WAY
- RAILROAD      RAILROAD RIGHT-OF-WAY
- STREAM, LAKE, ETC.      STREAM, LAKE, ETC.
- TAX LOT BOUNDARY      NON-BOUNDARY
- SUBDIVISION BOUNDARY      PARTITION PLAT BDT.
- TAX CODE BOUNDARY      EASEMENT

**SYMBOL TYPES**


- DLC
- CONTROL POINTS
- SURVEY MONUMENTS
- C.L.O. CORNERS
- SECTION
- 1/4 SEC
- 1/16 SEC
- 1/4 COR
- 1/32 COR

**NUMBERS**

TAX CODE NO.  
000 00 00 0

ACREAGE - ALL ACREAGES EXCLUDE ANY PORTION THAT MAY LIE WITHIN THE INDICATED PUBLIC RIGHT OF WAY

TICK MARKS - WHEN A TICK MARK IS INDICATED ON THE EXTENSION OF A LINE THEN THE DIMENSION GOES TO THE TICK MARK. GENERALLY THIS IS USED WHEN DIMENSIONS GO INTO PUBLIC RIGHT OF WAYS

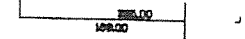


ARROWS ARE USED WITH DIMENSIONS IN AREAS OF GREATER COMPLEXITY.

**NOTICE:** This map was created for Assessor's Office use ONLY.



SCALE 1" = 200'  
or 1:2400

Plot file created: February 27, 1998

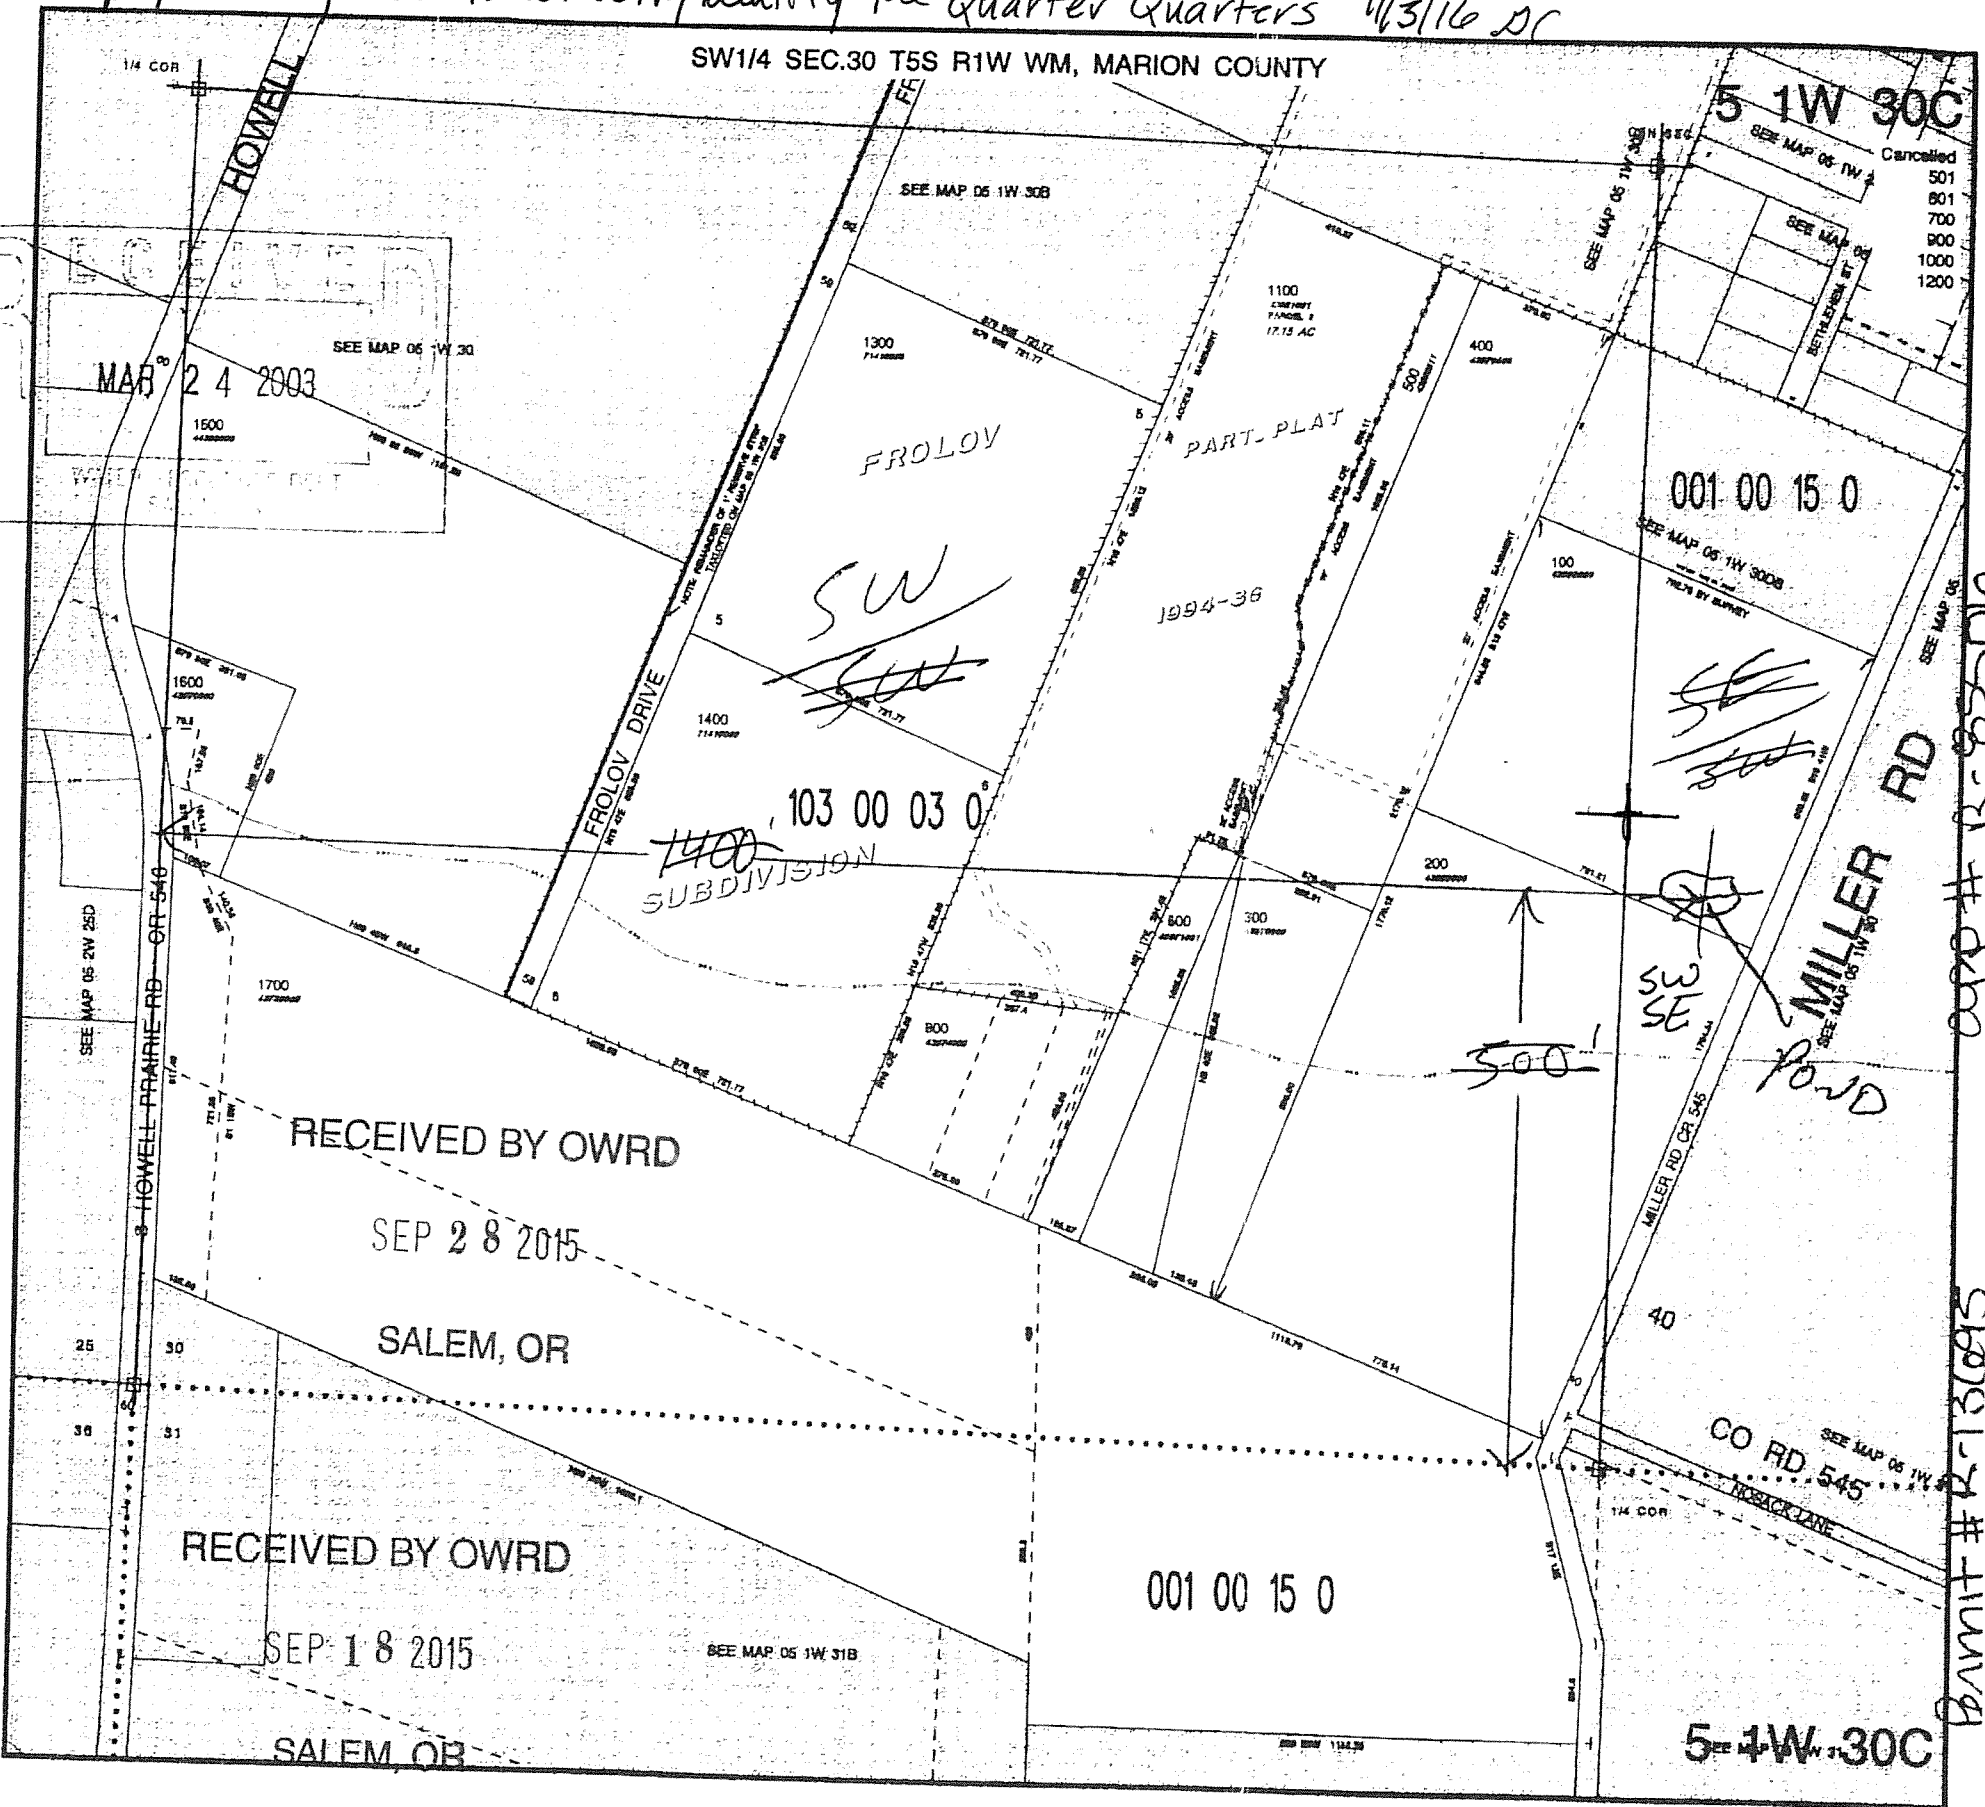

5 1W 30C

Cancelled
501
601
700
900
1000
1200

APP # R-85710  
STEP 1-13095