

SOUTH EAST QUARTER OF SECTION 25

T1N R32E

TAX LOT 06401


NORTH

SCALE 1" =

POND ONE

R32E

25

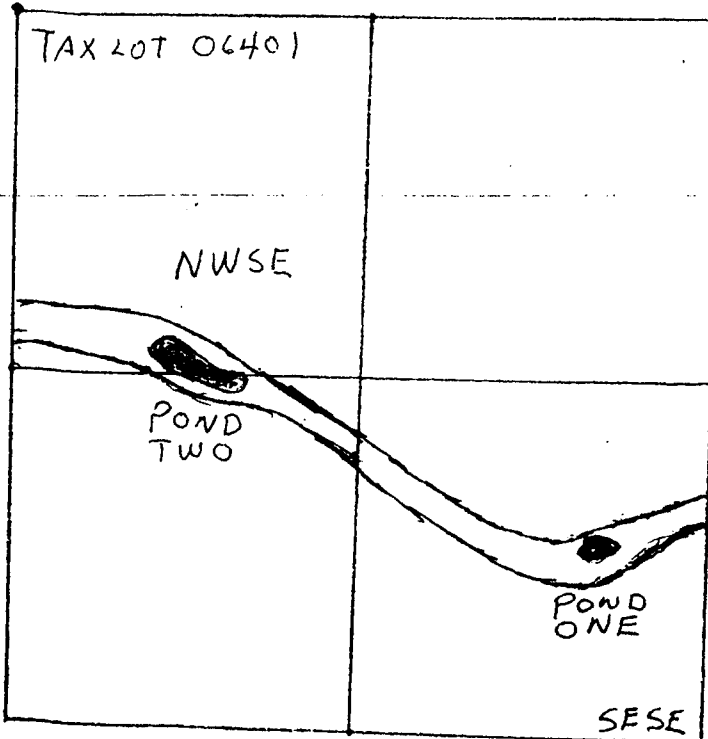

WEST

EAST

← 742.5 N 412 W. OF
SOUTHEAST CORNER
OF SECTION 25

SOUTH

Application No. R-8 5166
Permit No. R. 13436

RECEIVED BY OWRD

OCT 02 2015

SALEM, OR

RECEIVED

MAY 06 2002

WATER RESOURCES DEPT.
SALEM, OREGON