

RECEIVED

APR 01 2003


WATER RESOURCES DEPT.
SALEM, OREGON

R13E

RECEIVED

IAN 08 2003

WATER RESOURCES DEPT.
SALEM, OREGON

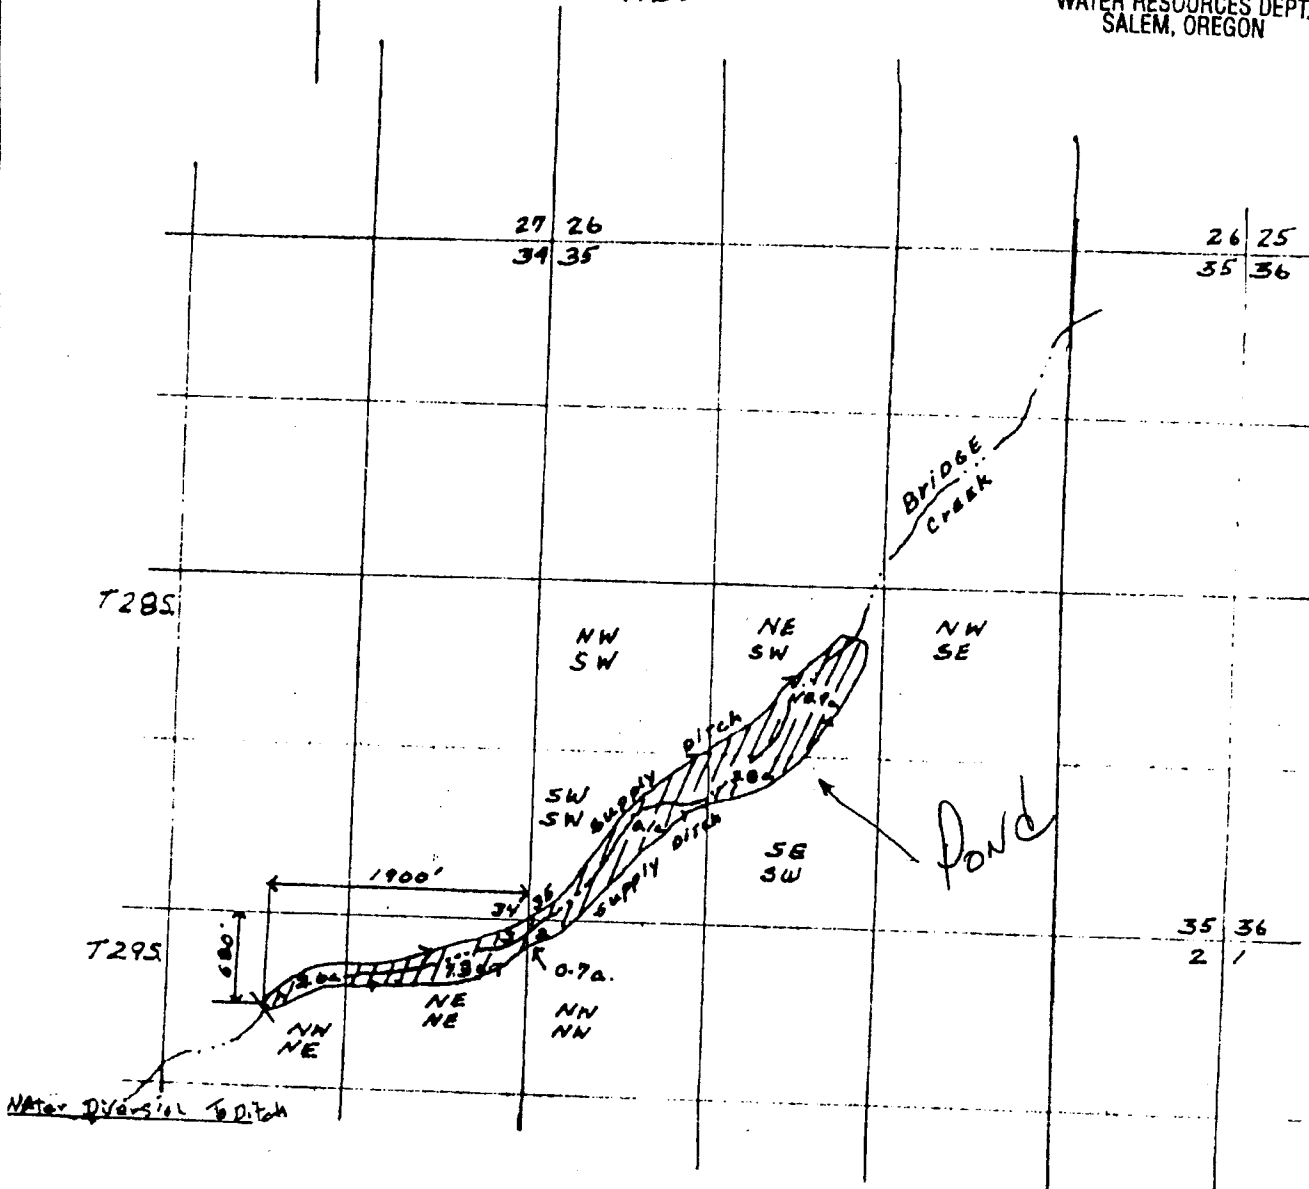

T 28 S R 13 E SEC. 35	
SW 1/4 SW 1/4	10.1 Acres
SE 1/4 SW 1/4	3.8 "
NE 1/4 SW 1/4	10.9 "
	24.8 ac
T 29 S R 13 E SEC. 3	
NW 1/4 NE 1/4	2.6 "
NE 1/4 NE 1/4	7.3 "
	9.9 ac
T 29 S. R 13 E SEC. 2	
NW 1/4 NW 1/4	0.7 "
	0.7 ac
Total	35.4 ac

App # R 85522
Permit # R-13665

JAMES SPHAR
BRIDGE CREEK MEADOW
EXISTING IRRIGATION SYSTEM
SCALE 1" = 1 MILE
DATA PLOTTED ON AERIAL

RECEIVED BY OWRD

SEP 10 2015

SALEM, OR