ECT
3 T1N R2W W.M.

HINGTON COUNTY OREGON
SCALE 1"=400'

PROPERTY ADDRESS:
22600 NW MEIER RD.
HILLSBORO, OR 97124

IN 2 3
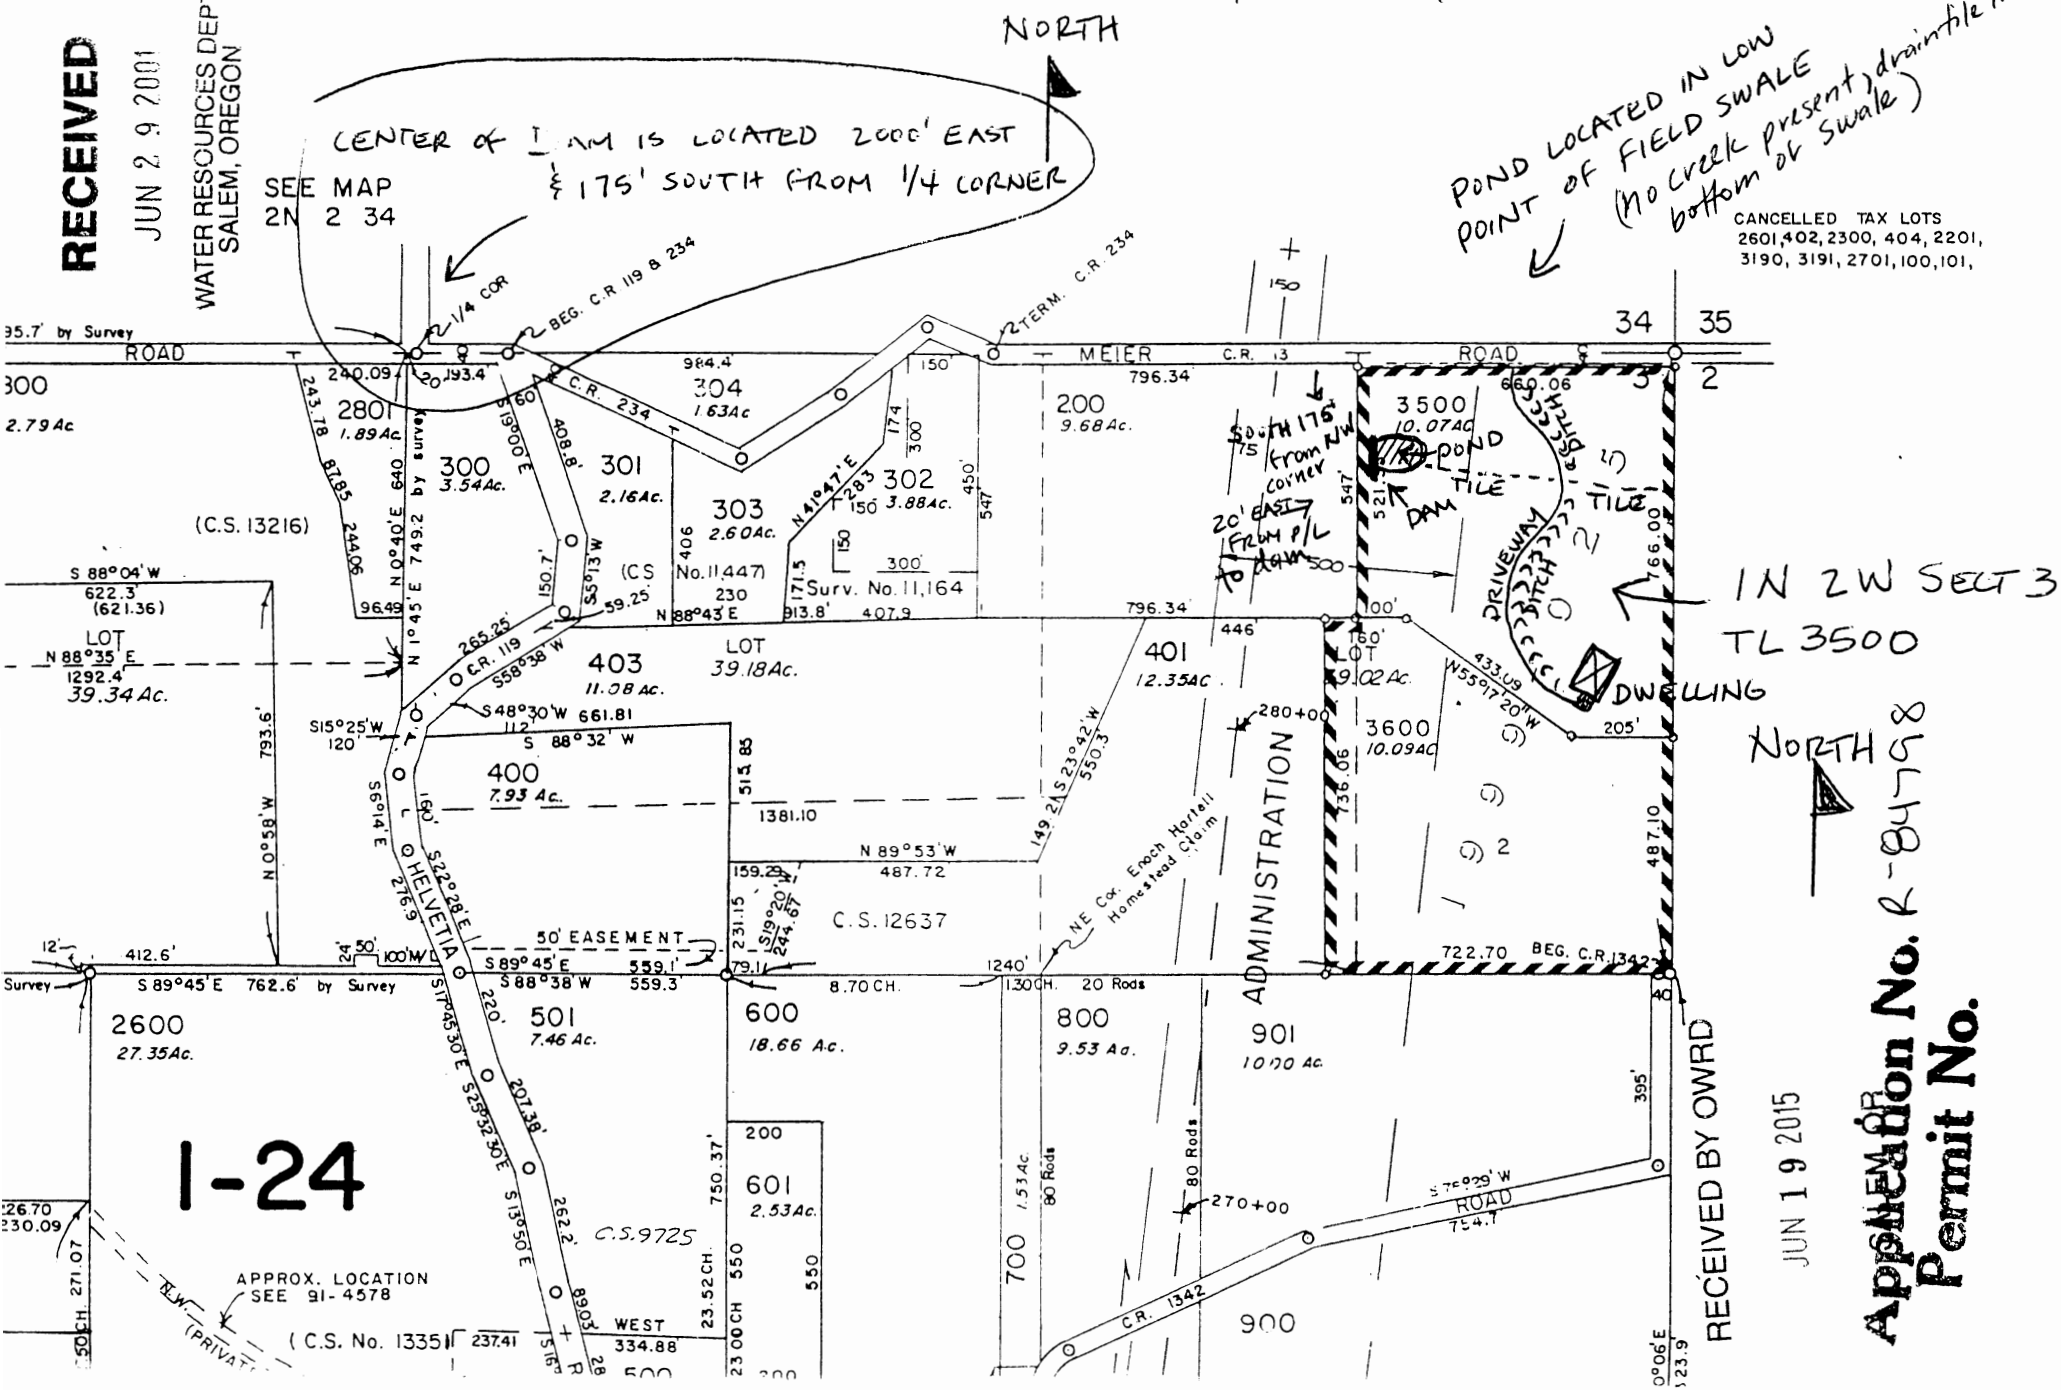
RECEIVED
JUN 2 9 2001
WATER RESOURCES DEPT
SALEM, OREGON