



RECEIVED BY OWRD

AUG 21 2015


SALEM, OR

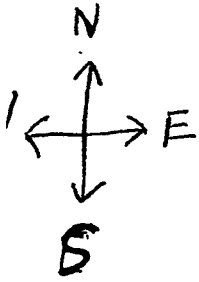


app# R-85331
Permit # R-13520

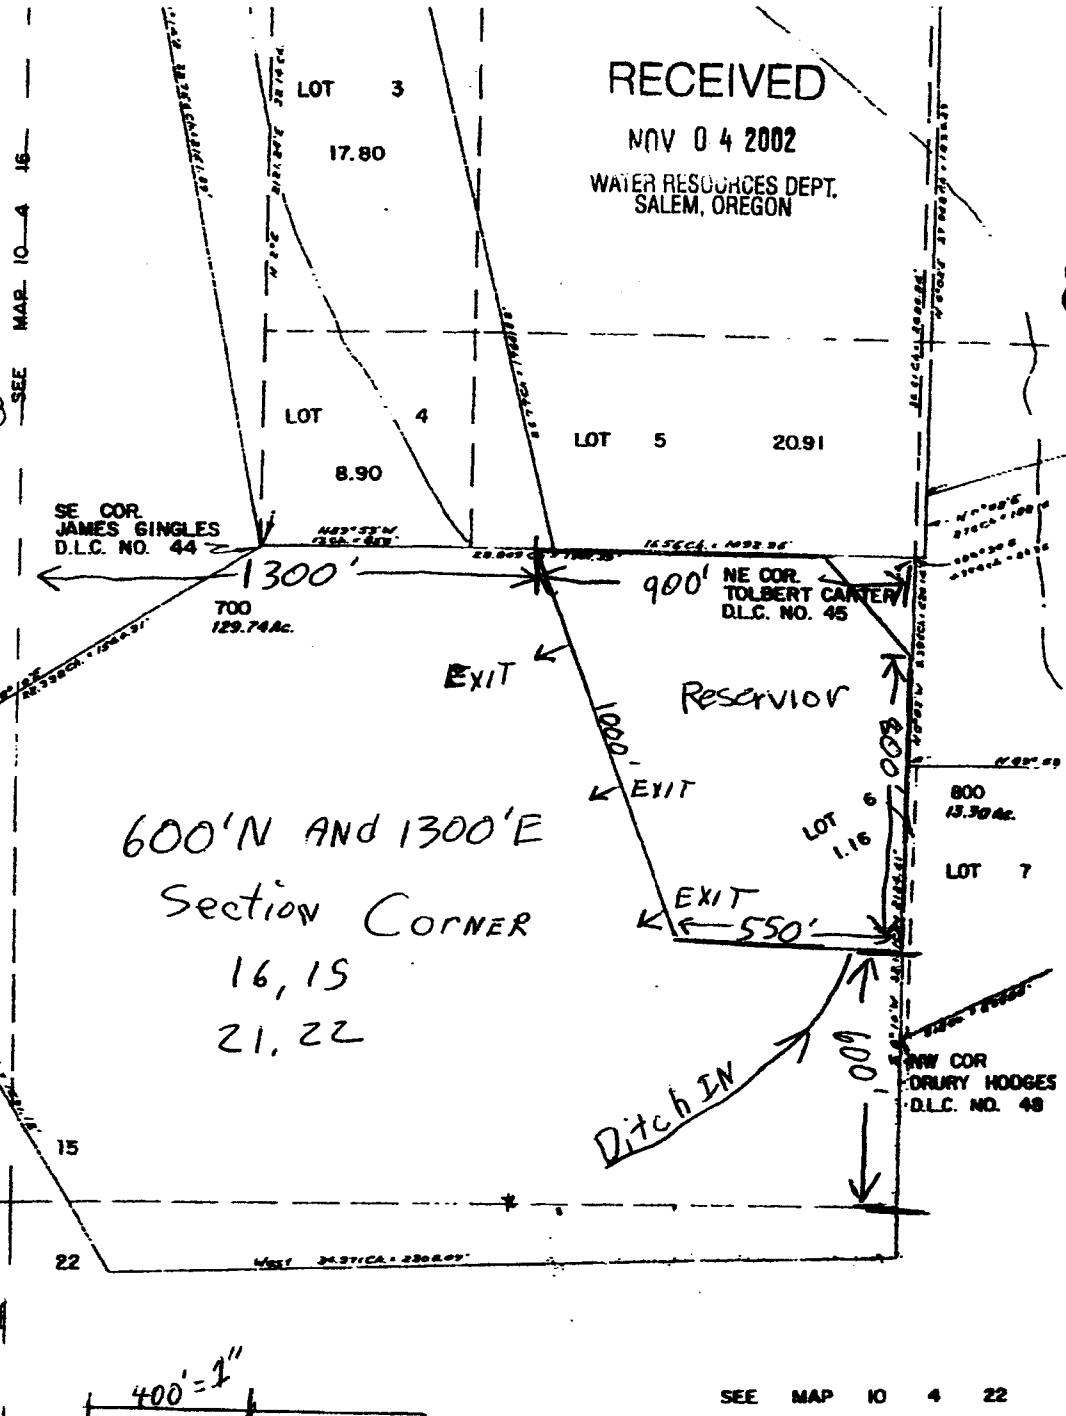

Marvin Gilmour, OWRD Application # R-85331, Permit R-13528

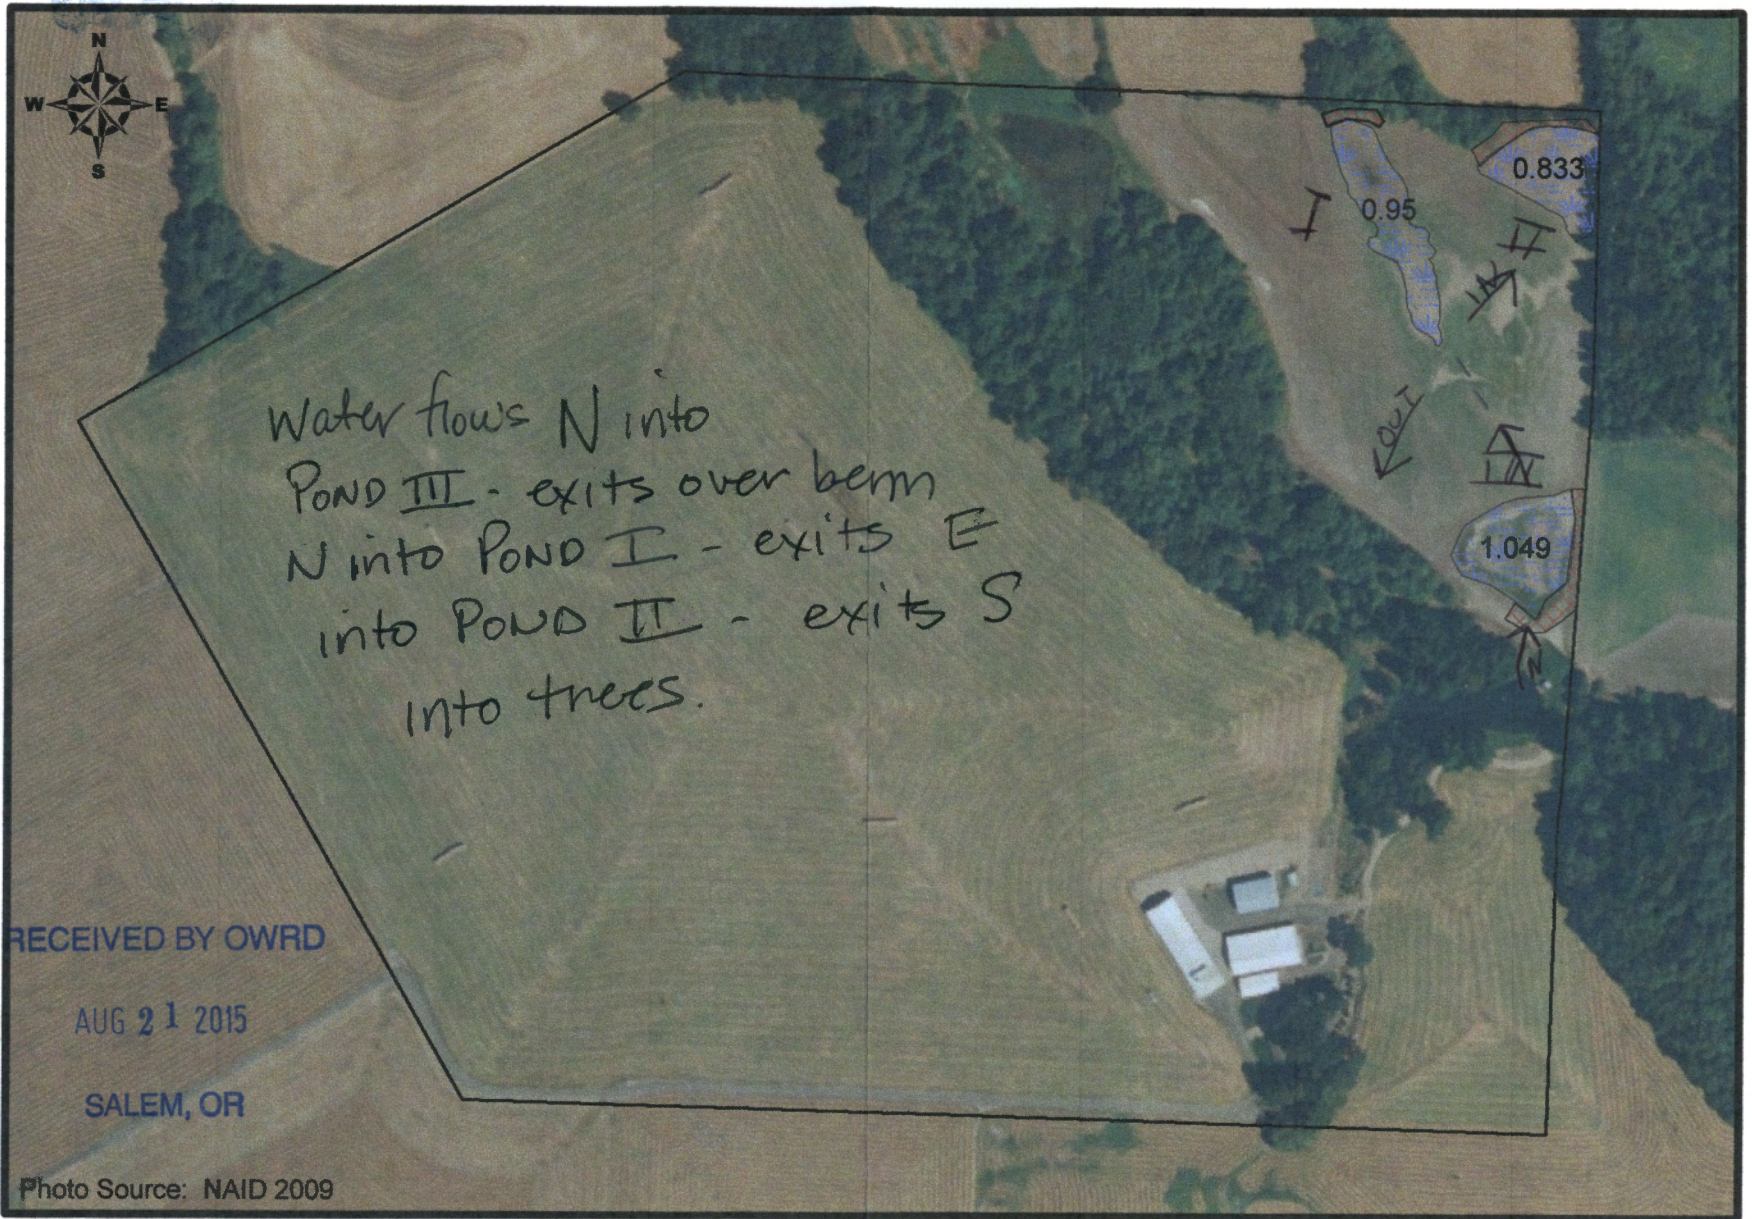

-  Shallow Berms
-  OWRD Appl #R-85331, Permit # R-13528
-  BentonTAXLOTS Gilmour

