


# CLAIM OF BENEFICIAL USE

## ALTERNATE REVIEW RESERVOIR

APPLICATION R-87987      PERMIT R-15082  
 IN THE NAME OF FREEL & ASSOCIATES, LLC  
 TOWNSHIP 35 S., RANGE 1W., W.M.

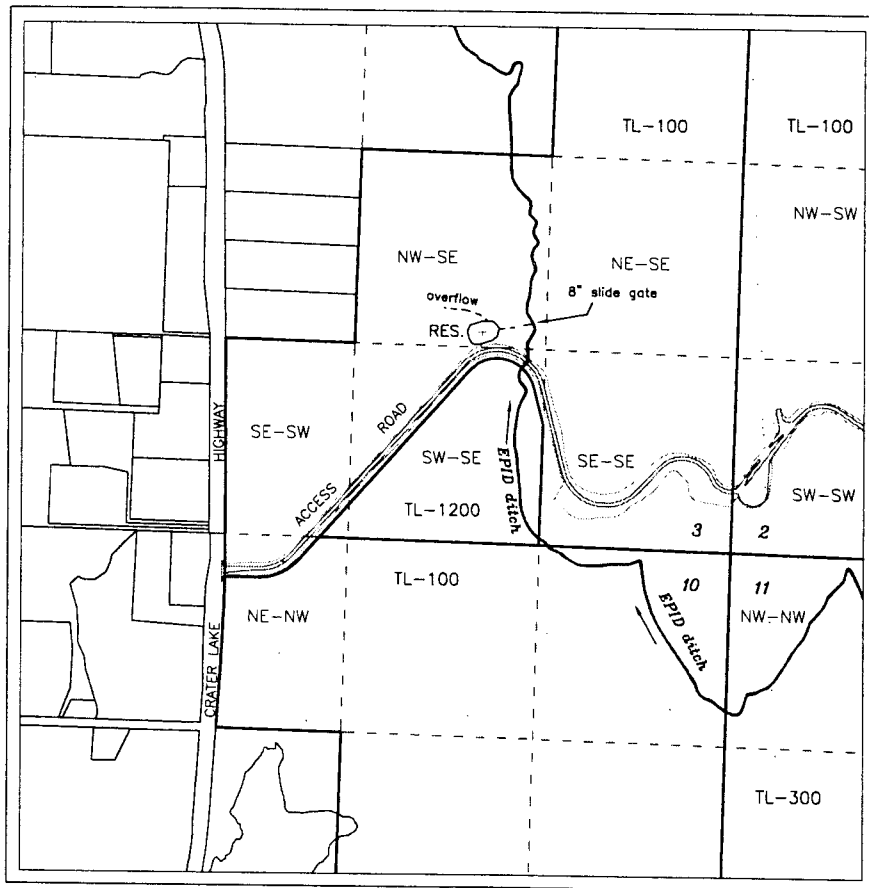

RECEIVED BY OWRD


JUN 30 2015

SALEM, OR

Center of Reservoir - 1440 feet North and  
 1750 feet West from the SE corner Section 3

Scale

1" = 1320'

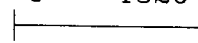

MULTI-PURPOSE RESERVOIR  
 NAME: PDQ Reservoir  
 SOURCE - Surface seepage & Runoff  
 including runoff in EPID ditch  
 Capacity - 6 Acre-Feet

Freel & Associates, LLC  
 P.O. Box 587  
 Shady Cove, OR 97539



This map is not intended to provide legal  
 dimensions or locations of property ownership lines

Base map - Jackson County GIS Tax  
 Lots with FPS map, site plan map  
 overlays on 2005 FSA aerial photo  
 for assumed best fit

6/1/2015 n.e.d.