


T. 32 S., R. 35 E., W.M.

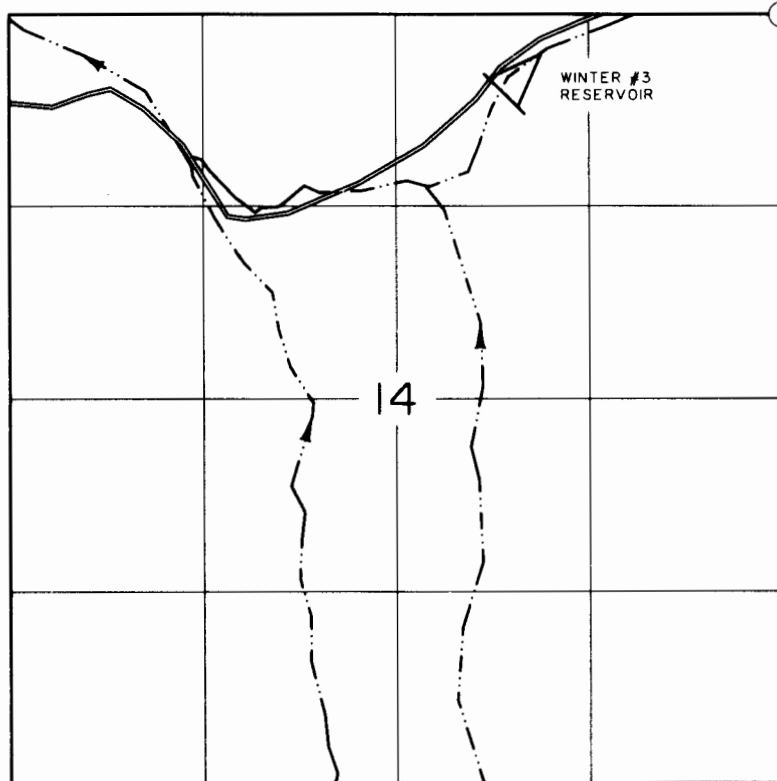

1" = 1320'



STONE

DIVERSION IS 540
FEET SOUTH AND
1870 FEET WEST
OF THE NE CORNER
OF SECTION 14.

RECEIVED

AUG 30 1999

**WATER RESOURCES DEPT.
SALEM, OREGON**

CLAIM OF BENEFICIAL USE MAP

IN NAME OF

UNITED STATES BUREAU OF LAND MANAGEMENT

APPLICATION NO. R-73906

PERMIT NO. R-11568



EXPIRES 6/30/00

SURVEYED: JUNE 30, 1999

THE PURPOSE OF THIS MAP IS FOR IDENTIFYING THE LOCATION OF THE WATER RIGHT ONLY AND
IS NOT INTENDED TO PROVIDE LEGAL DIMENSIONS OR LOCATION OF PROPERTY OWNERSHIP LINES.

U.S. BUREAU OF LAND MANAGEMENT-OSO
BRANCH OF GEOGRAPHIC SCIENCES

DWG: WINTER3

EXECUTED BY:
DANIEL E. WELLER, PLS, CWRE
P.O. BOX 2965
PORTLAND, OREGON 97208